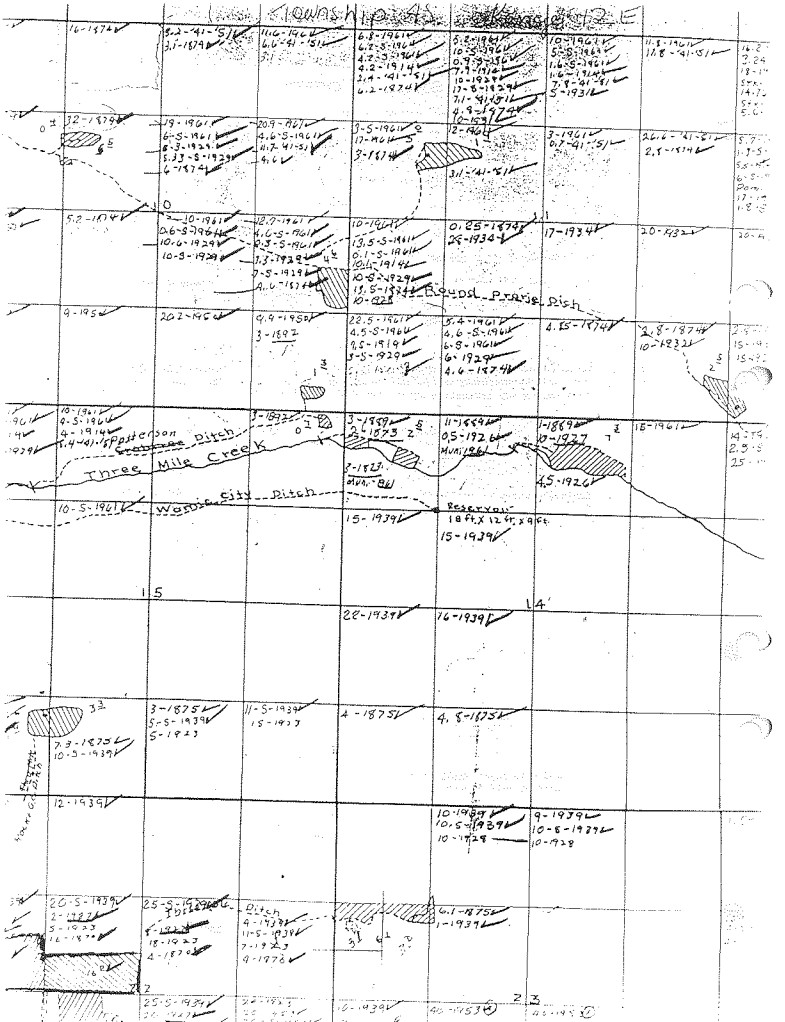
Three Mile Creek
Patterson Ditch
Reservoir
18 Ft. X 12 Ft. X 4 Ft.