


T. 4S., R. 40E. W.M.

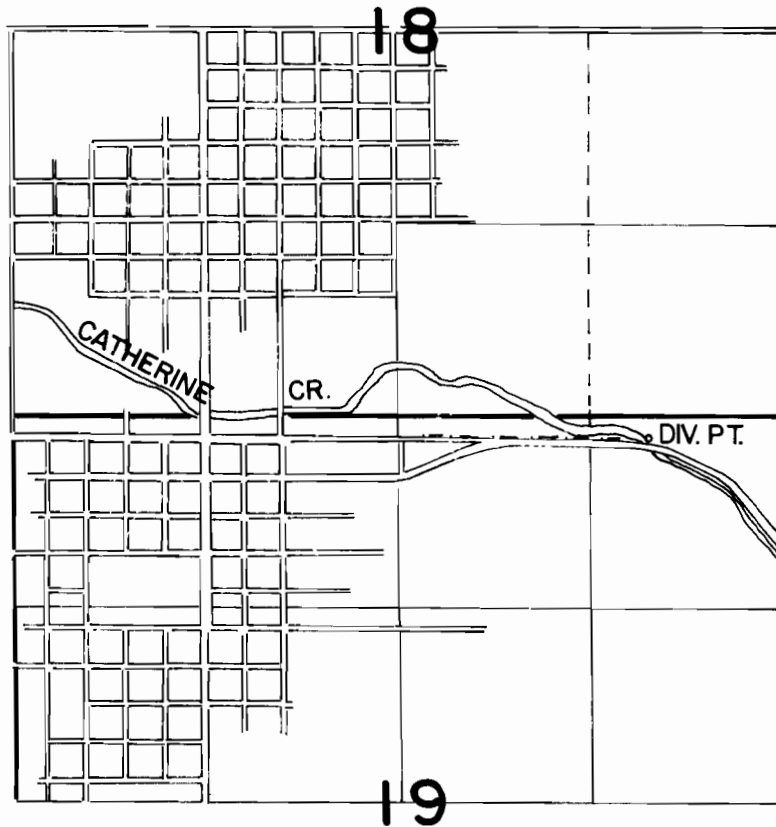

SCALE: 1" = 1320'

DIV. PT. LOCATED 150'S. & 1730'E. FROM N1/4 COR. SEC. 19

FINAL PROOF SURVEY
UNDER

TRANSFER 3256
IN NAME OF

.....GUILD... UNITED... DITCHES.....

Surveyed ..7...9..... 1984., by V...L...CHURCH....