


T.6S., R.2W., W.M.

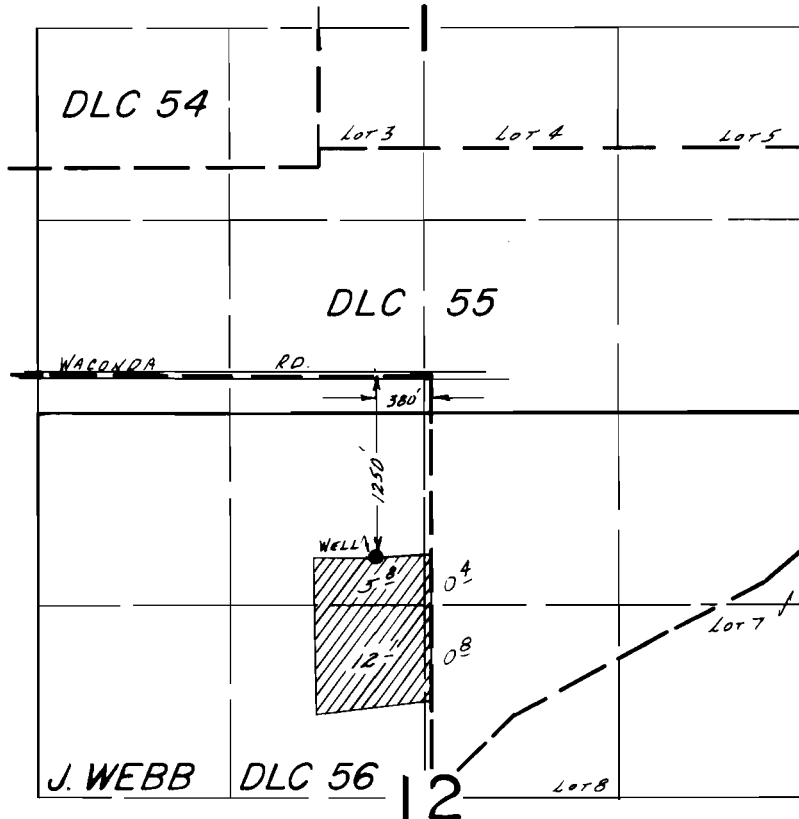

SCALE: 1" = 1320'

FINAL PROOF SURVEY UNDER

Application No. G-6162.. Permit No. G-5845.....
IN NAME OF

...EDWARD PETER SCHLECHTER

Surveyed MAY 12, 1980, by B.W. BISHOP.....

REVISED
1-20-88 BWS
DFN-6LL-201