


T.14S.,R.13E.,W.M.
NW1/4 SW1/4 Sec. 21

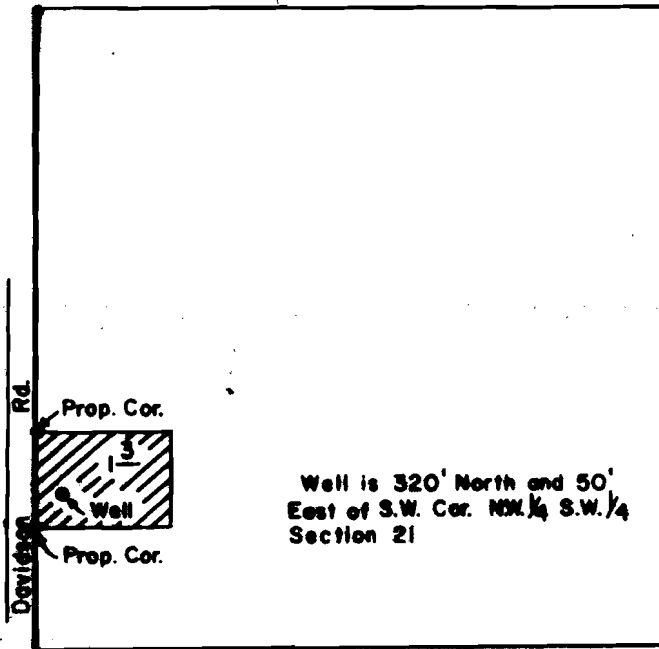

SCALE: 1" = 400'

FINAL PROOF SURVEY
UNDER

Application No. G-7506 Permit No. G-6985
IN NAME OF

FRED & DOLORES CRAWFORD

Surveyed OCT. 6, 1983, by D. PANTHER

C-57442

SEE
DESC
2470