


# T. 7S., R. 5W., W.M.

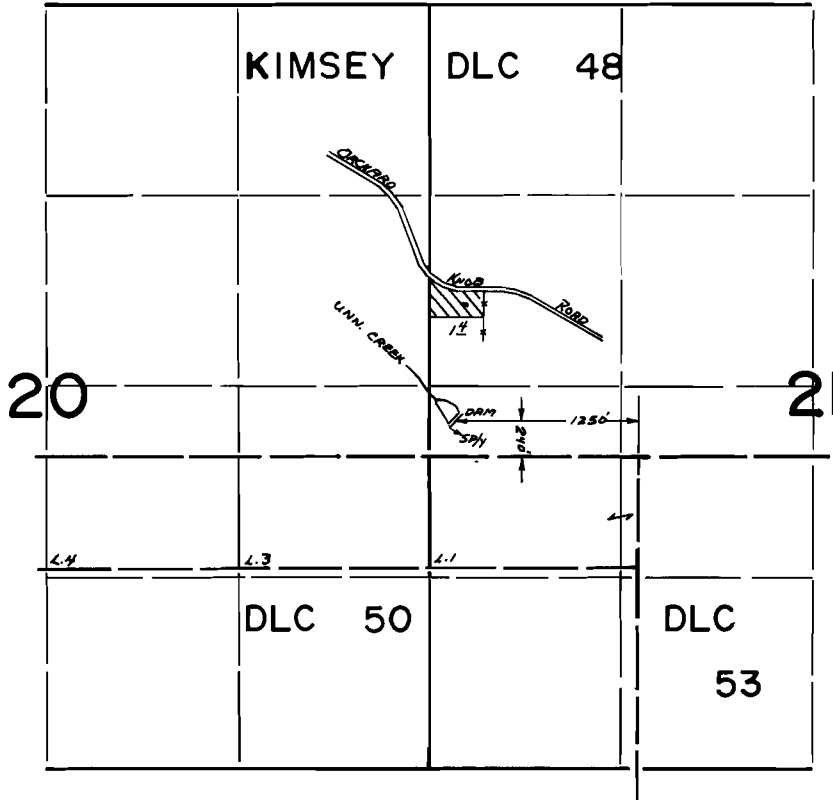

## FINAL PROOF SURVEY UNDER

R-52859                      R-6418  
 Application No. ..5286Q Permit No. 40292.....  
 IN NAME OF

..... LARRY M. LENON .....

Surveyed .Oct..14.. 19.81., by ..L..T.OLL.....