


T. 7S., R. 5W., W.M.

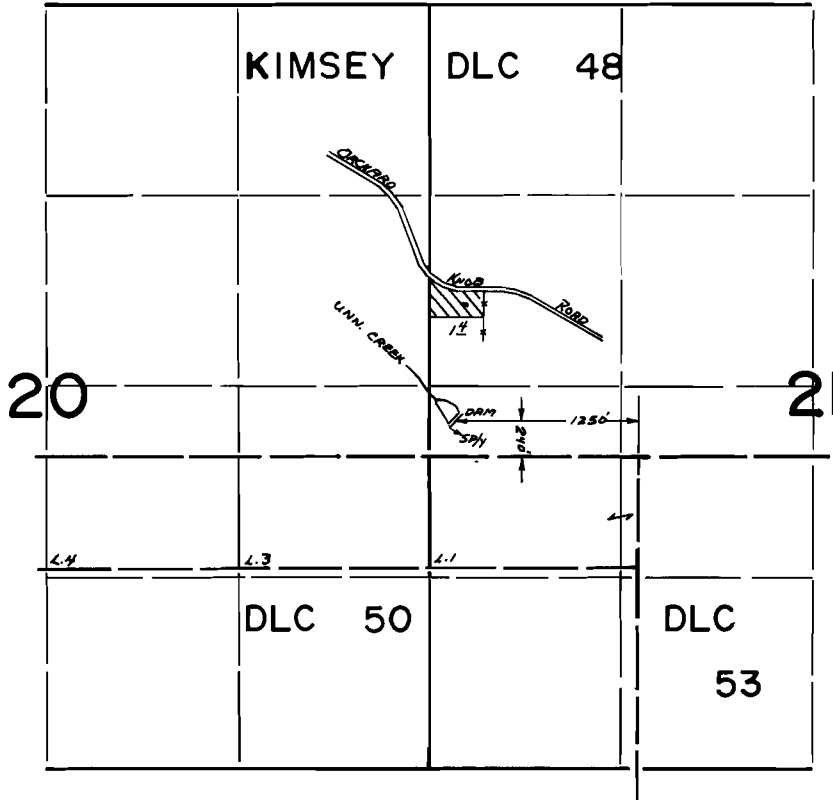

FINAL PROOF SURVEY UNDER

R-52859 R-6418
 Application No. ..5286Q Permit No. 40292.....
 IN NAME OF

.....LARRY M. LENON.....

Surveyed .Oct..14.. 19.81., by ..L..T.OLL.....