T.3S., R.8W., W.M.

(SECTION 17)

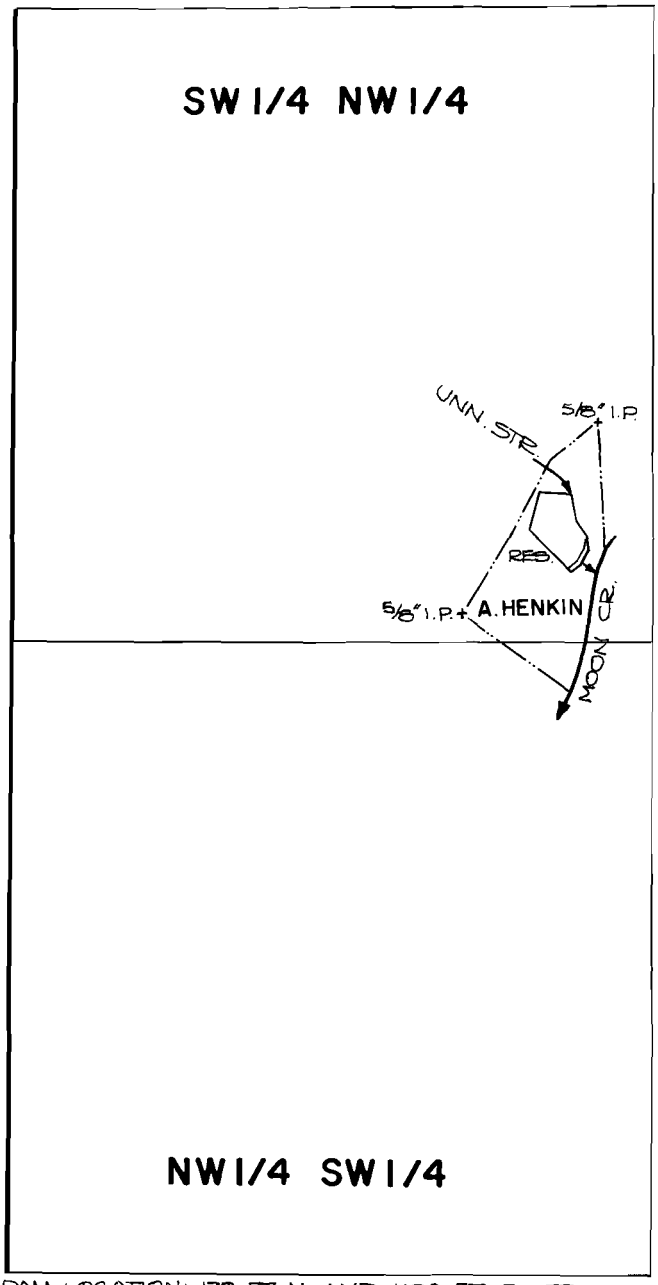

DAM LOCATION: 170 FT. N. AND 1190 FT. E. FROM THE W. 1/4 CORNER OF SECTION 17.

N

FINAL PROOF SURVEY

UNDER

SCALE: 1" = 400'

Application No. R-52678 52679 Permit No. R-6445 40439

IN NAME OF

ALBERT HENKIN

Surveyed SEPT. 10, 1984, by P. Payton

PTS-1984-AA PRP 12/13/84