


T.7S.,R.5W.,W.M.

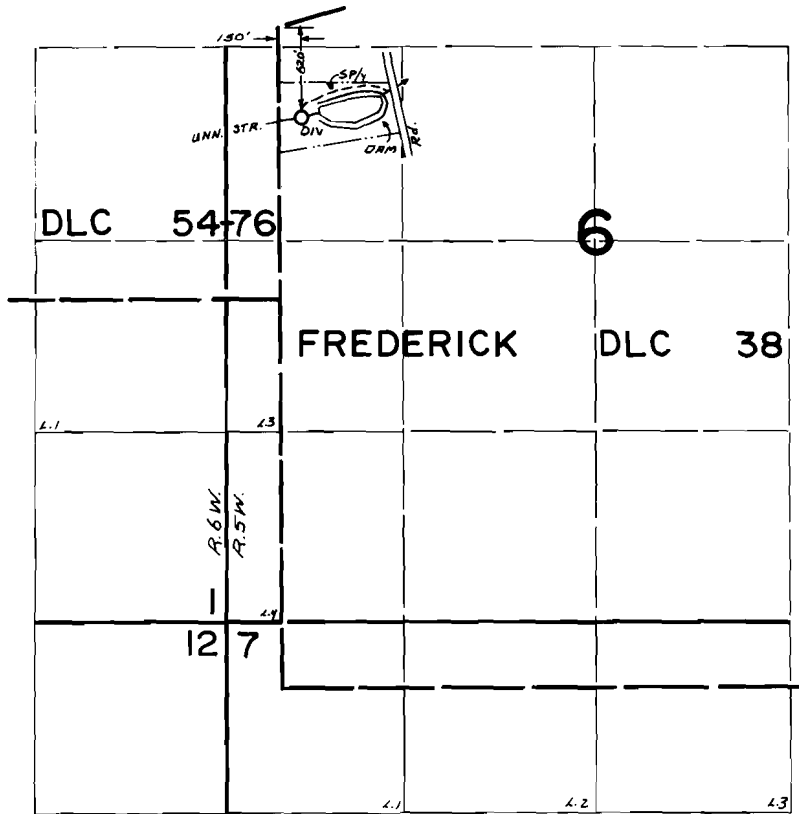

FINAL PROOF SURVEY UNDER

Application No. R-54212 54213 Permit No. R-6474 40588
IN NAME OF

ELDON JAMES WYSCARVER

Surveyed Oct. 13 1981, by L. TOLL