



# T.3S., R.5W., W. M.

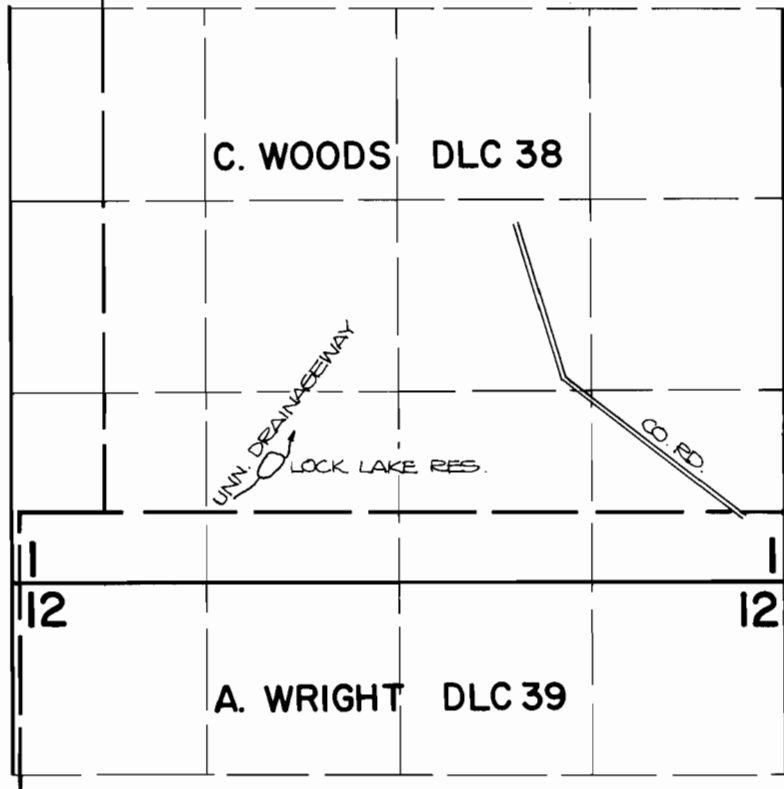

DAM LOCATION: 740 FT. N. AND 1250 FT. E. FROM THE S.W. CORNER OF SECTION 11.

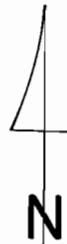

SCALE: 4" = 1 MILE

## FINAL PROOF SURVEY UNDER

R-54554                      R-6522  
Application No. 54555... Permit No. 40909.....  
IN NAME OF

..... O. J. LOCKLEAR .....

Surveyed JULY 24, 1984, by P. Patten.....