



T.3S., R.5W., W.M.

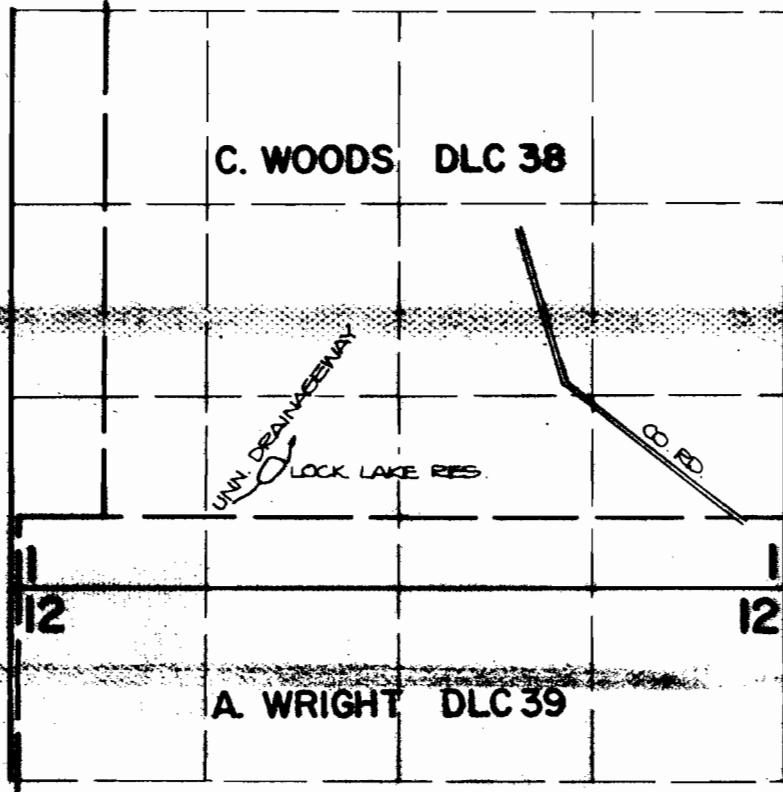

DAM LOCATION: 740 FT. N. AND 1000 FT. E. FROM THE S.W. CORNER OF SECTION 1.

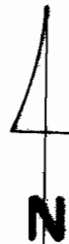

**FINAL PROOF SURVEY**  
UNDER

SCALE: 4" = 1 MILE

R-54554 R-6522  
Application No. 54555 Permit No. 40909  
IN NAME OF

O. J. LOCKLEAR

Surveyed JULY 24, 1984, by P. Porter