


T.8S.,R.5&6W.,W.M.

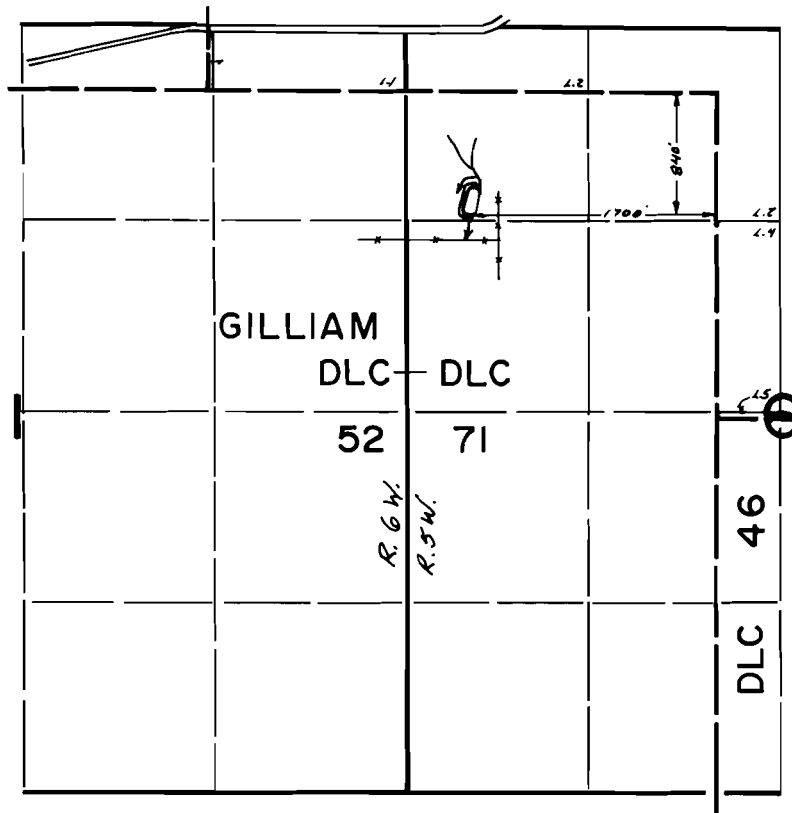

FINAL PROOF SURVEY
UNDER

R-54632 R-6530
Application No. 54633 Permit No. 40917.....
IN NAME OF

.....CHARLES W. PARKER.....

Surveyed Sept. 10, 1981, by L. TOLL.....