


T.8S.,R.5&6W.,W.M.

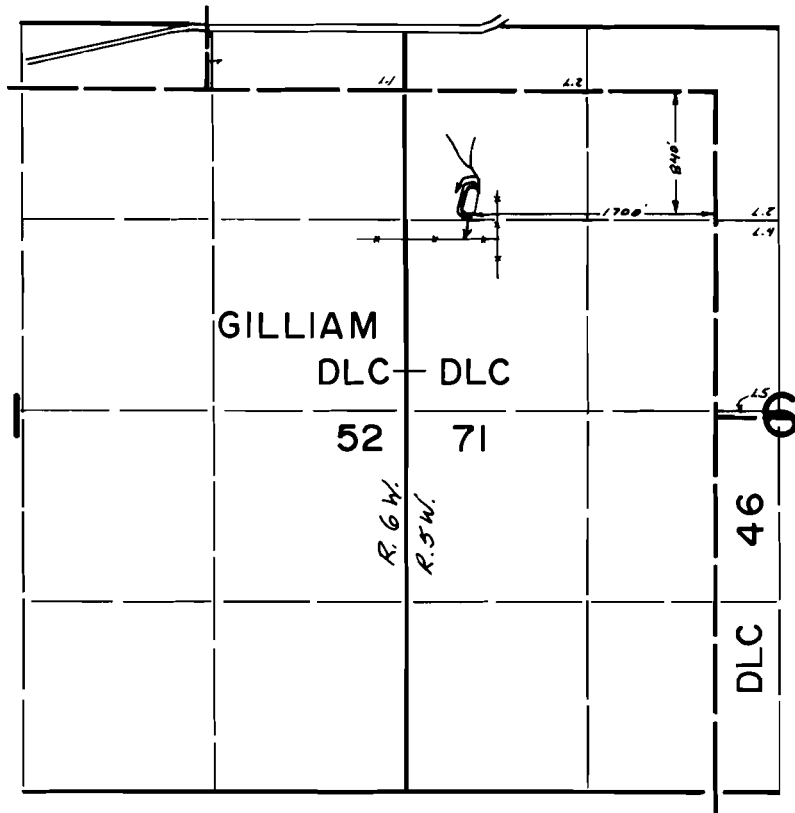

FINAL PROOF SURVEY UNDER

R-54632 R-6530
Application No. 54633. Permit No. 40917.....
IN NAME OF

.....CHARLES W. PARKER.....

Surveyed Sept. 10. 1981, by ...L...TOLL.....