


T.2S.,R.3W.,W.M.

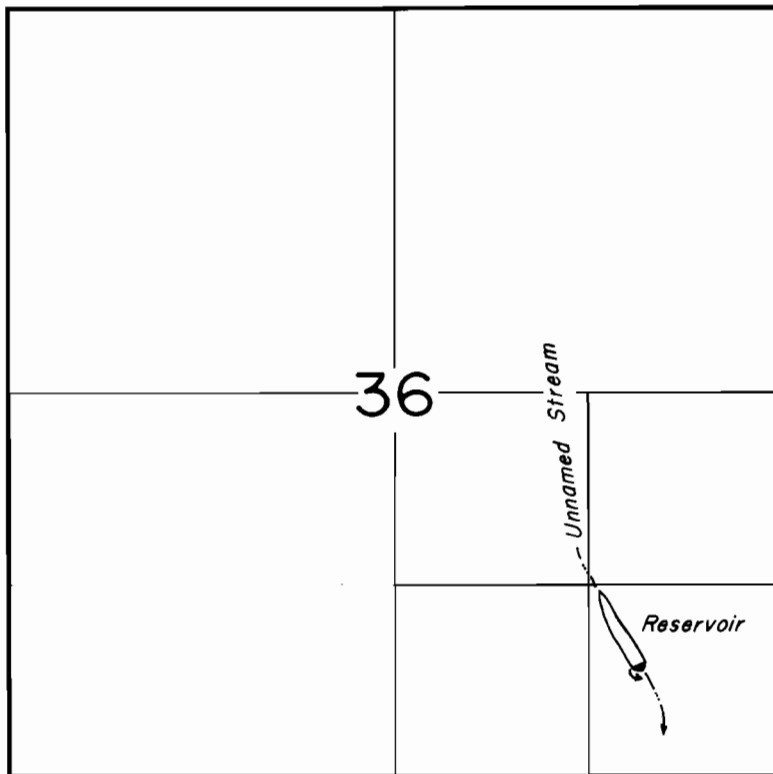

DAM LOC.: 760 Ft. N. & 950 Ft. W. from SE Corner Sec. 36

FINAL PROOF SURVEY
UNDER

R-54509 R-6564
Application No. 54510... Permit No. 41356.....

IN NAME OF

Harry N. & Debra A. Potts

Surveyed June 19, 1979, by *d.B. Potts*