



LEGEND: H=HOUSE C=CABIN

### FINAL PROOF SURVEY UNDER

Application No. 38474... Permit No. 28649...  
IN NAME OF  
OAK GROVE WATER COMPANY  
Surveyed May 15, 1980, by R.G. MUCKEN

a reduced copy

SPRING LOCATION

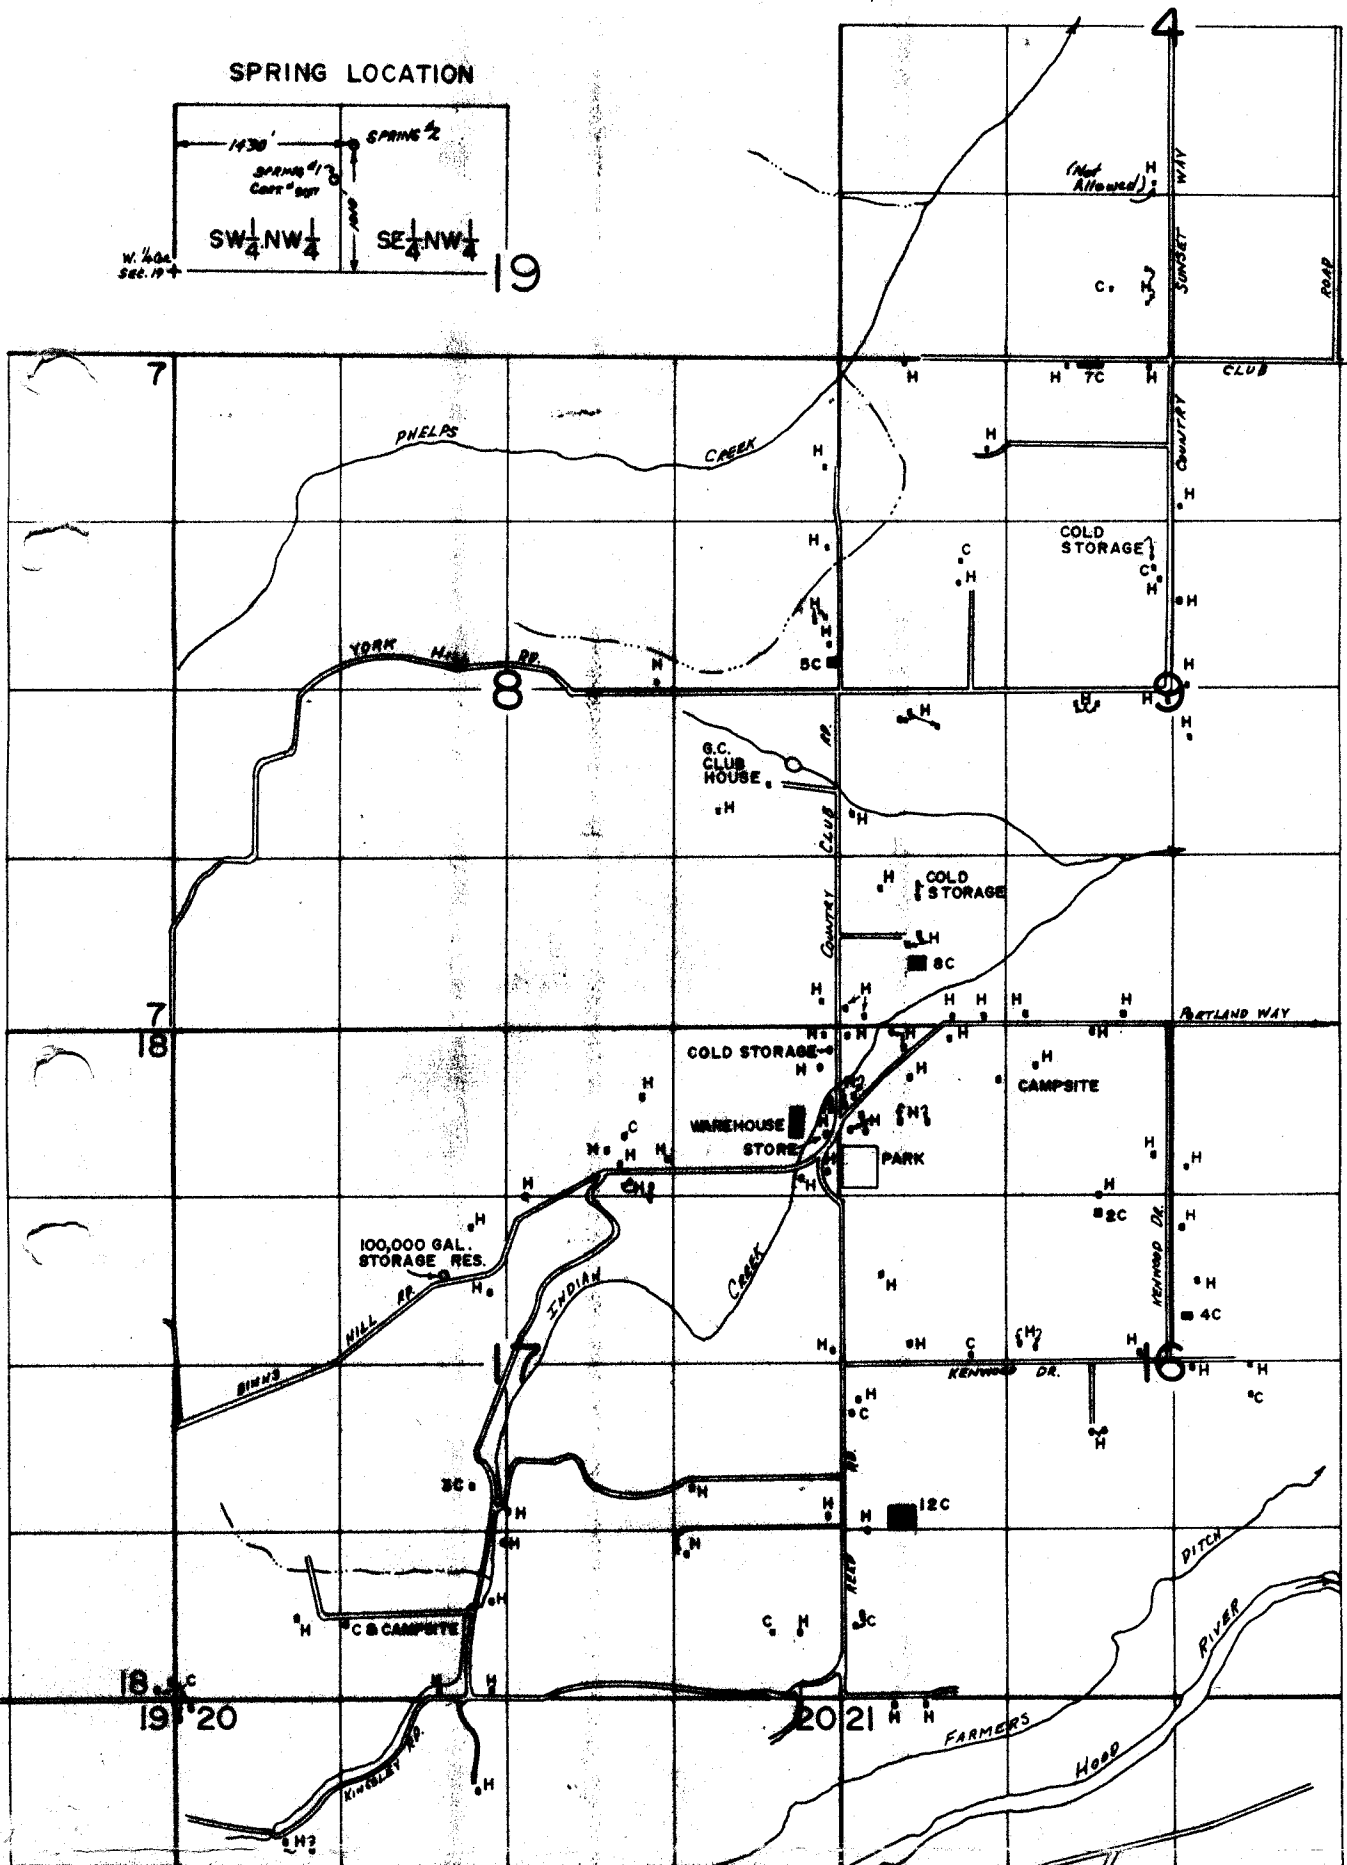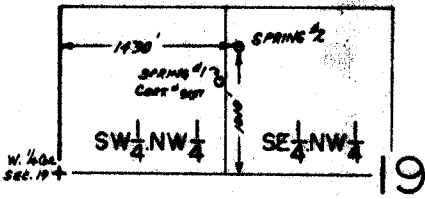

LEGEND: H=HOUSE C=CABIN