


T.6S.R.10W.W.M.

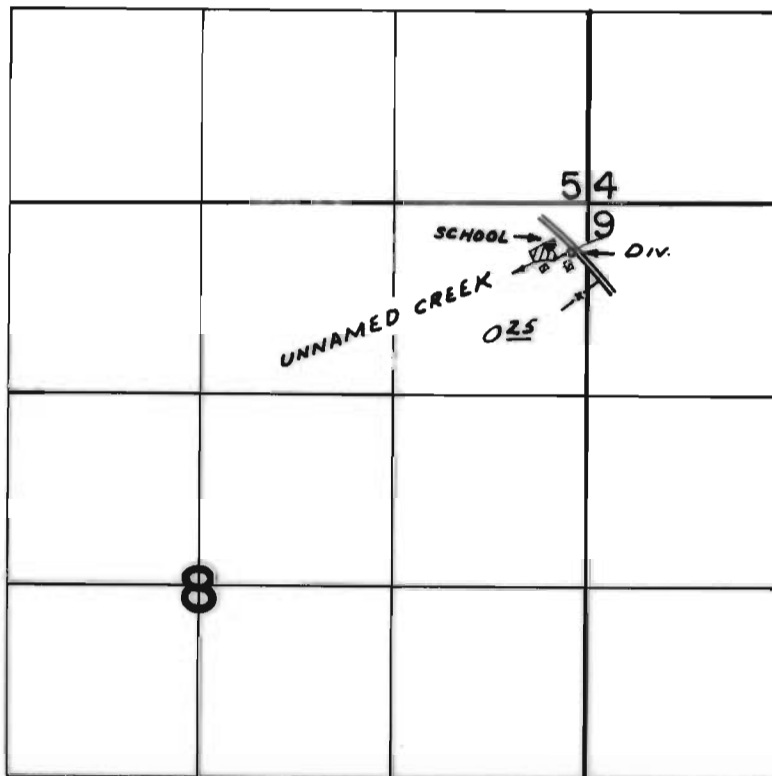

DIV. PT. LOC: 330' S. & 120' W. FROM N.E. COR. SEC. 8

FINAL PROOF SURVEY

UNDER

Application No. 51747... Permit No. 37337....
IN NAME OF

.....GEORGE MURRAY THOMPSON

Surveyed SEPT. 14, 1978, by C.L. HUGHES
JAN. 21, 1980, R. MUCKEN

1978-H