


T. 3 S. R. 5 W. W.M.

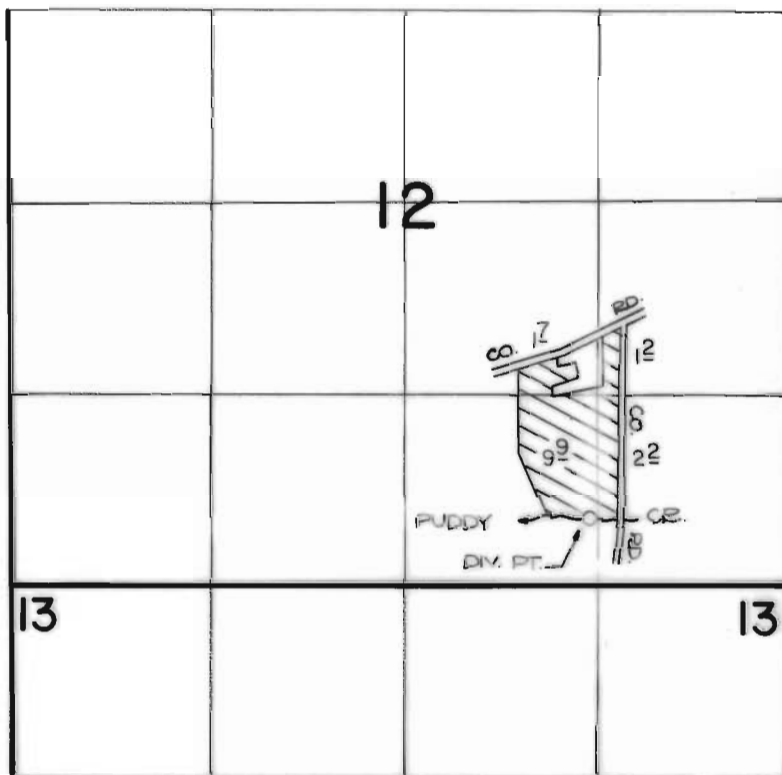

DIVISION POINT IS LOCATED 450' N. AND 1380' W.
FROM THE S.E. CORNER OF SECTION 12.

FINAL PROOF SURVEY UNDER

Application No. 52666.... Permit No. 37838.....
IN NAME OF

.....**JOHN GOEHNER**.....

Surveyed NOV. 9..... 19.83., by P. P. Patten.....