
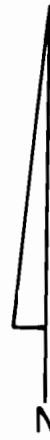


# T. 1 S., R. 8 W., W.M.

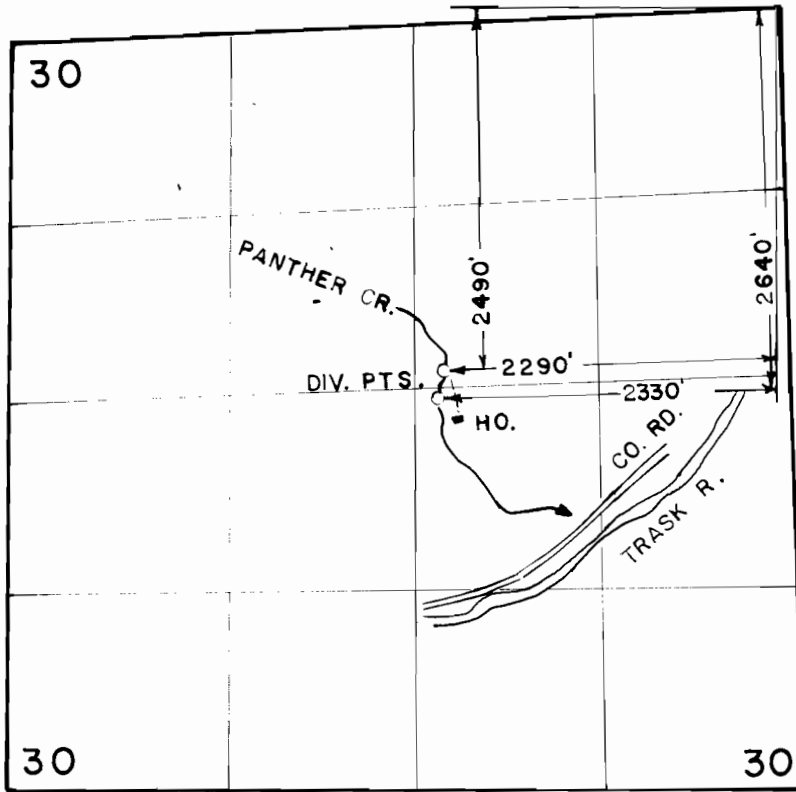

SCALE  
1" = 1320'

## FINAL PROOF SURVEY UNDER

Application No. 52477 Permit No. 39457  
IN NAME OF

RICHARD D. BROWN

Surveyed JUN. 13. 1984., by P. PAGTER