


T. 36 S., R. 4 W., W.M.

VOID  
1-5-88

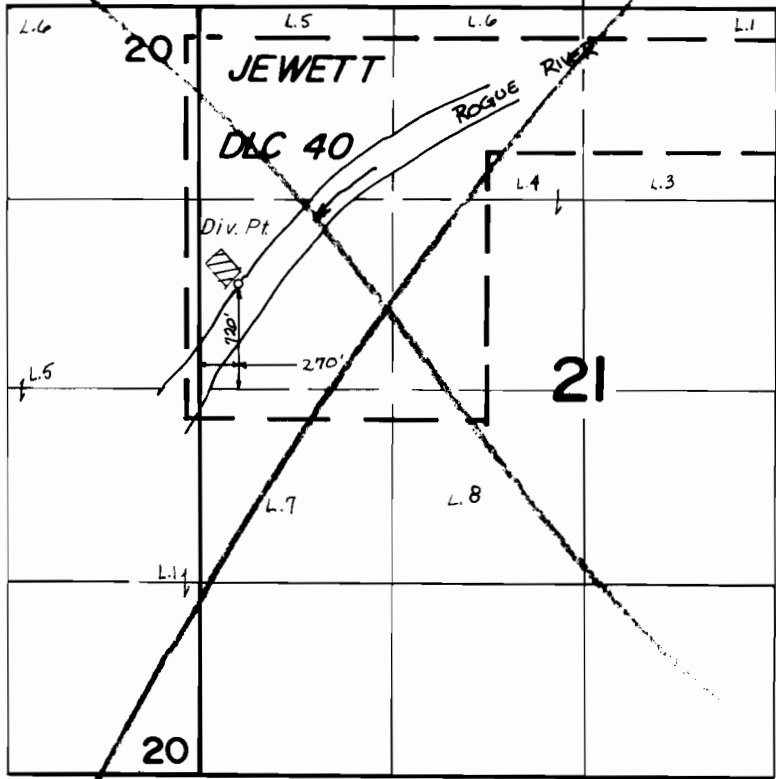

1" = 1320'

**FINAL PROOF SURVEY**  
UNDER

Application No. 52530 Permit No. 39644

IN NAME OF

M. J. DODRILL

Surveyed April 22, 1983, by B. S. JAMES