


# T.35S., R.3 W., W.M.

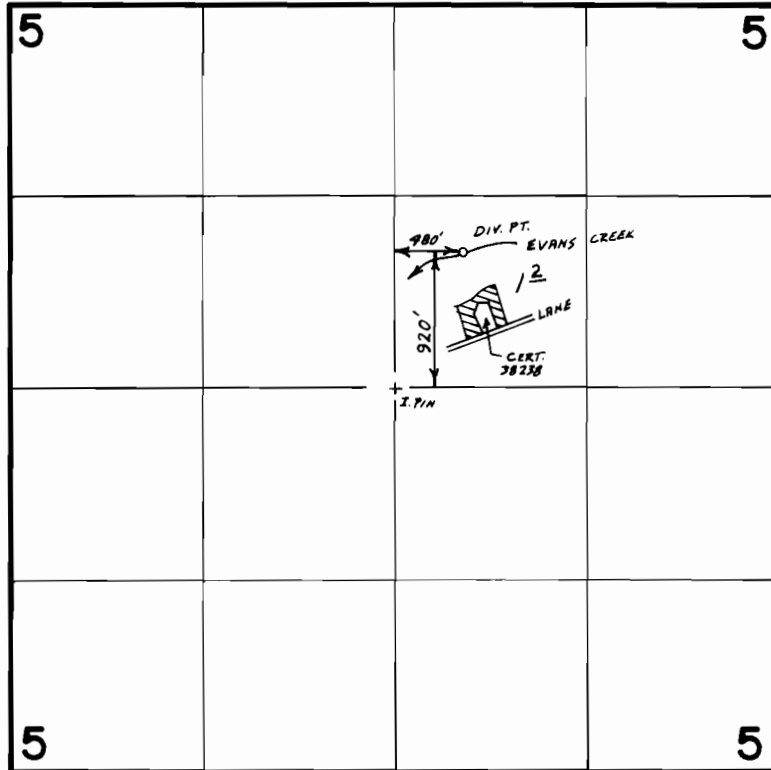

SCALE 1" = 1320'

## FINAL PROOF SURVEY UNDER

Application No. 53005 Permit No. 40009.....  
IN NAME OF

WALTER E. ZAHLMANN.....

Surveyed Nov. 13., 1984, by J.R. WOODROOF.