


T.5S., R.6W., W. M.

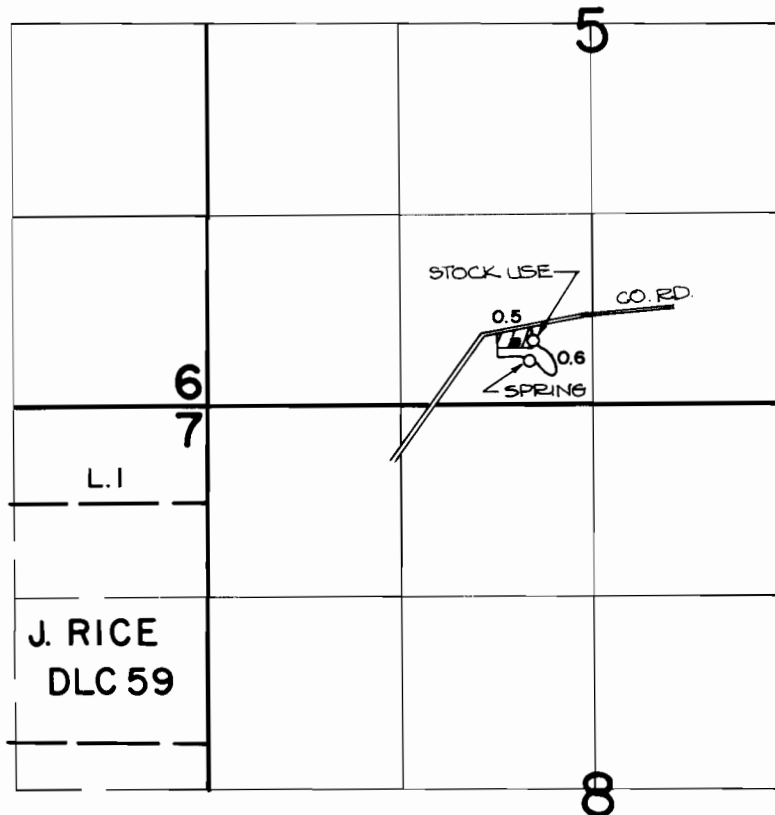

SPRING LOCATION: 300 FT. N. AND 2200 FT. E. FROM
THE S.W. CORNER OF SECTION 5.



FINAL PROOF SURVEY
UNDER

SCALE: 4" = 1 MILE

Application No. 53016... Permit No. 40015.....
IN NAME OF

NORMAN G. & TEMPE T. BERGGREN

Surveyed OCT. 29... 1984, by *P. Patten*