


# T.16S.,R.2E.,W.M.

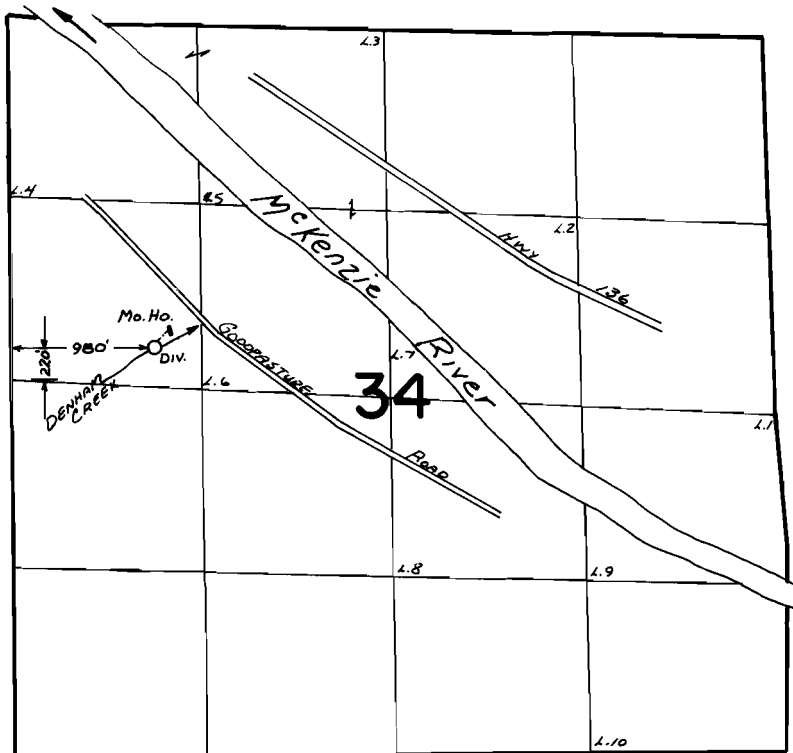

## FINAL PROOF SURVEY UNDER

Application No. 53209.. Permit No. 40046.....

IN NAME OF

HERBERT H. DENHAM

Surveyed Aug. 21... 1980., by S. C. BROWN.....