


T. 12 S., R. 6 W., W. M.

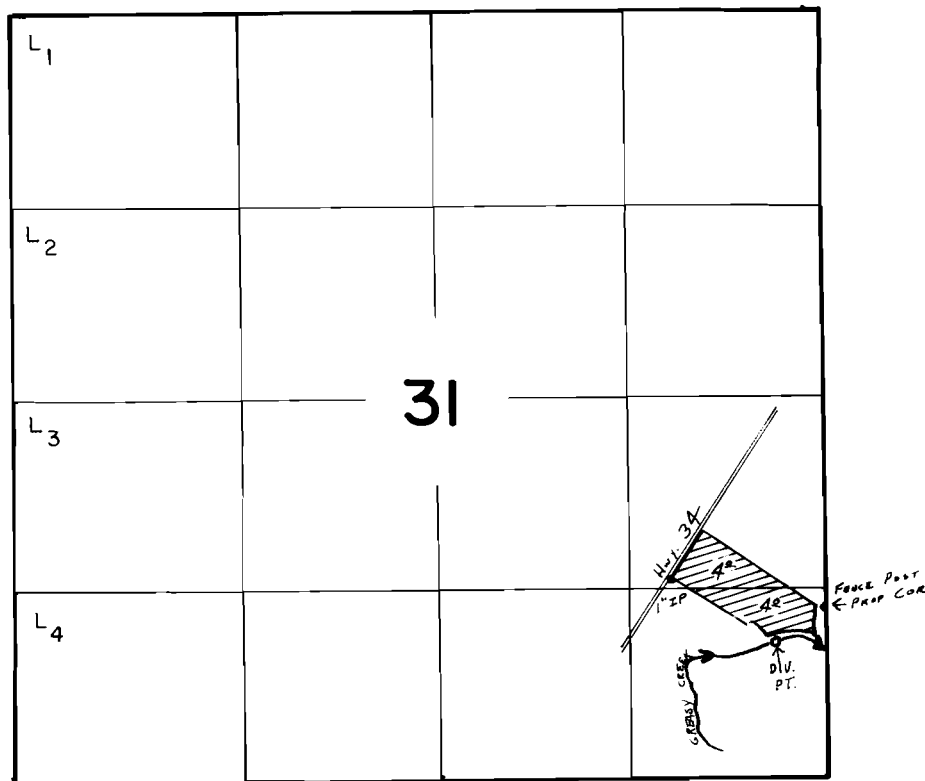

DIV. PT. LOC.: 920' N. & 330' W. from SE Cor. Sec. 31

Scale: 1" = 1320'

FINAL PROOF SURVEY UNDER

Application No. 53506. Permit No. 40050.....
IN NAME OF

ROBERT W. & CAROL J. CHALLIS

Surveyed JUNE 17, 1983, by L. TOLL.....