


T.14S.,R.1W.,W.M.

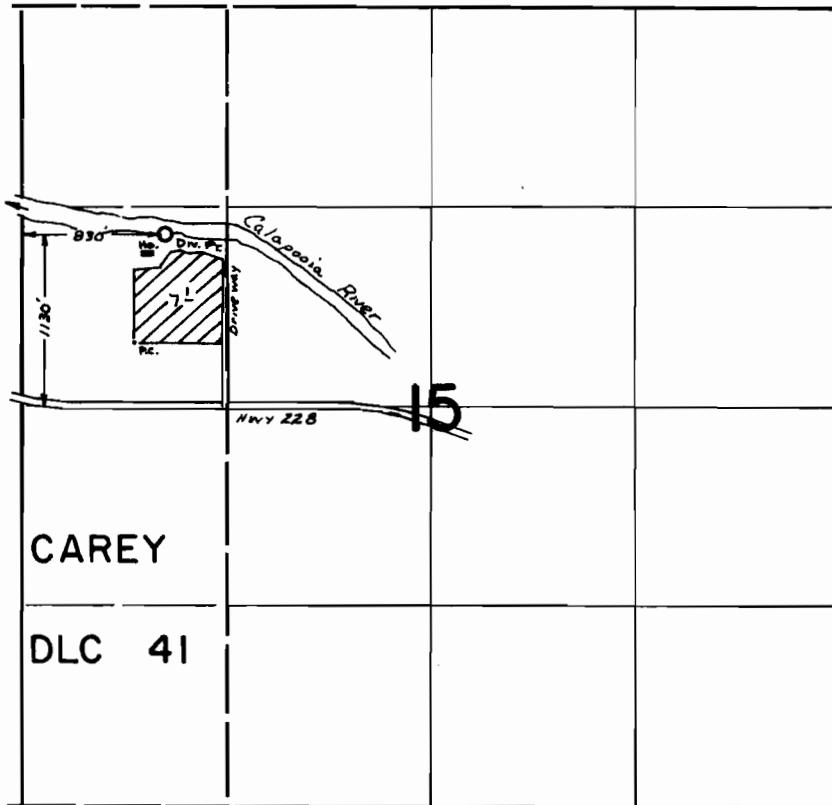

FINAL PROOF SURVEY UNDER

Application No. ..53569.. Permit No. ...40084.....
IN NAME OF

.....**LEROY ROWE**.....

Surveyed April..22.. 1982., by ..L..M..TOLL.....

RECEIVED
NOV 03 2006
WATER RESOURCES DEPT
SALEM, OREGON