


T.10S.,R.2W.,W.M.

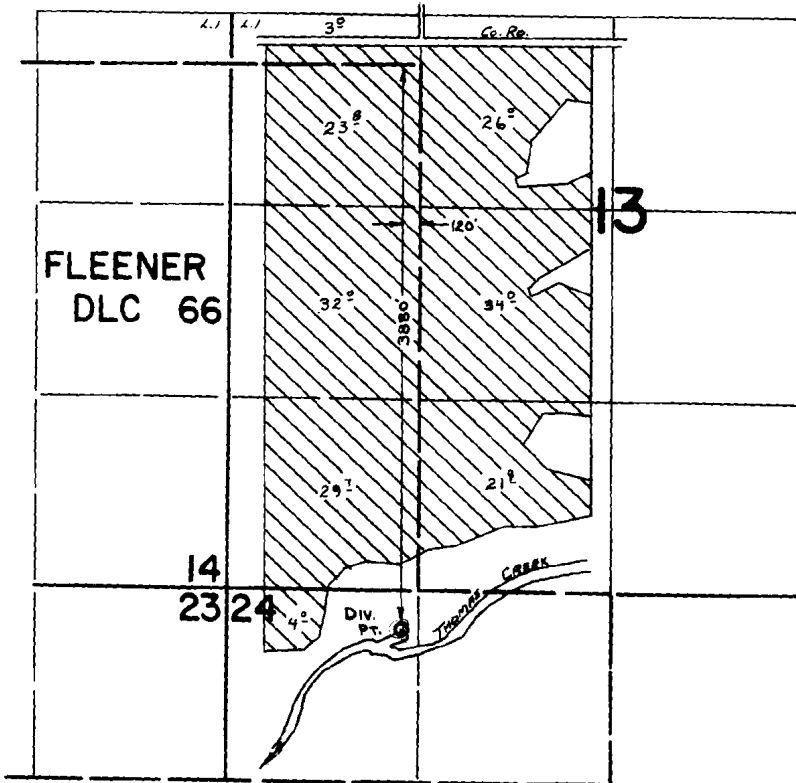

FINAL PROOF SURVEY UNDER

Application No. .53674.. Permit No. ...40132.....
IN NAME OF

.....KENNETH ELLIS.....

Surveyed July...6... 19.82., by L.M. TOLL.....