


T. 11 S., R. 7 W., W.M.

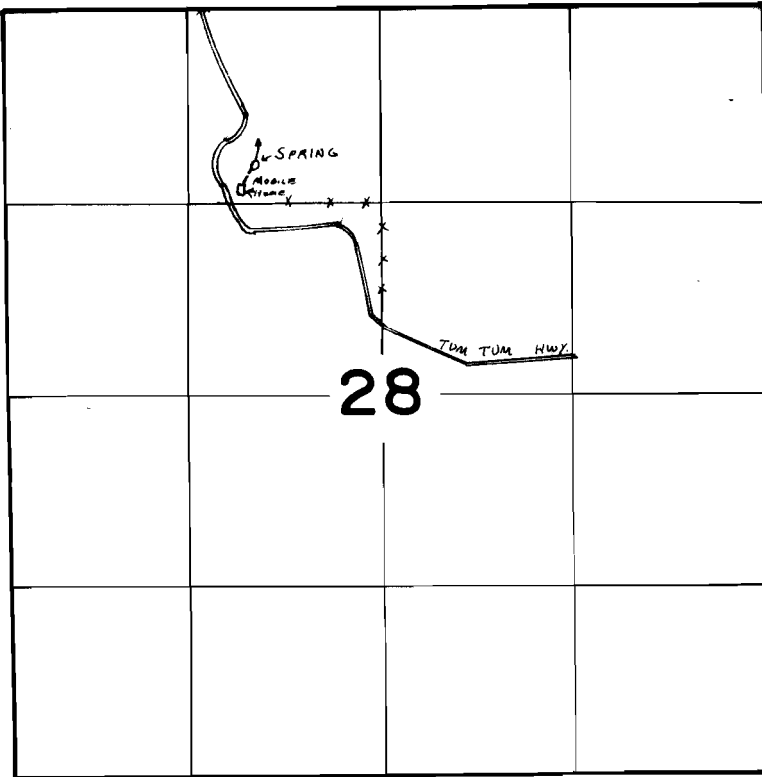

DIV. PT. LOC.: 1050' S. & 860' W. from N. 1/4 Cor.  
Section 28

**FINAL PROOF SURVEY**  
UNDER

Application No. 53697.. Permit No. 40145.....  
IN NAME OF

...MELVIN...L...ELLIOT.....

Surveyed JUNE...8... 1983, by ...L...TOLL.....