


T.12S., R.26E., W.M.

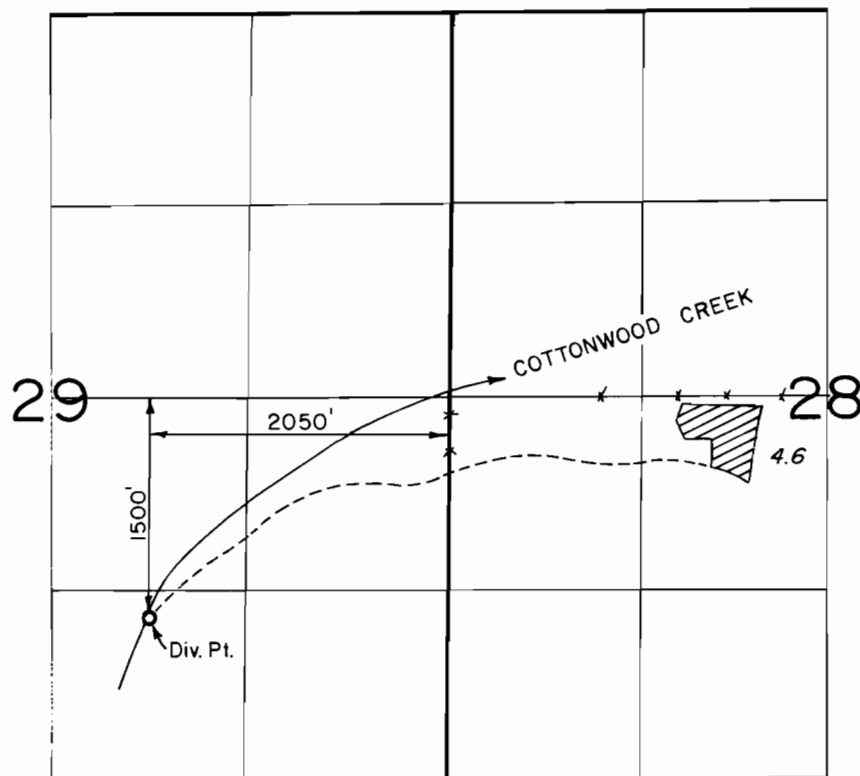

FINAL PROOF SURVEY
UNDER

Application No. 53845 Permit No. 40186
IN NAME OF

PETER C. & BRENDA HETTINGA

Surveyed OCT. 1, 1981, by *McBroom*