


T.3S.R.9W.W.M.

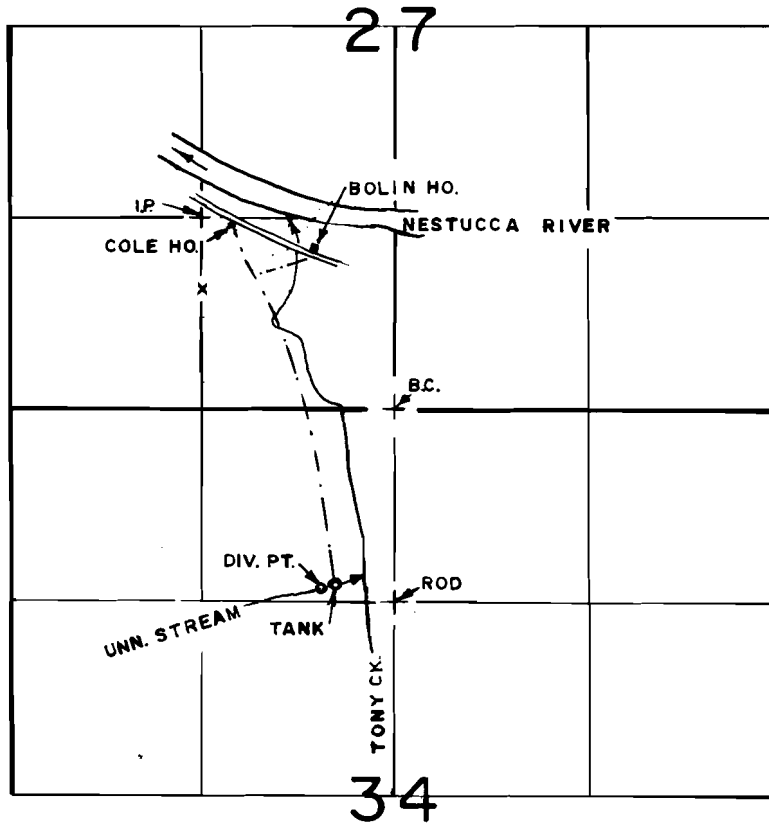

DIV. PT. LOC.: 1200' S. & 500' W. FROM N. 1/4 COR. SEC. 34

FINAL PROOF SURVEY UNDER

Application No. 53901, Permit No. 40219.....
IN NAME OF

.....GLENN B. COLE & ROBERT S. BOLIN.....

Surveyed FEB. 13, 1980, by R.G. MUCKEN.....