


T.5N.R.6&7W.W.M.

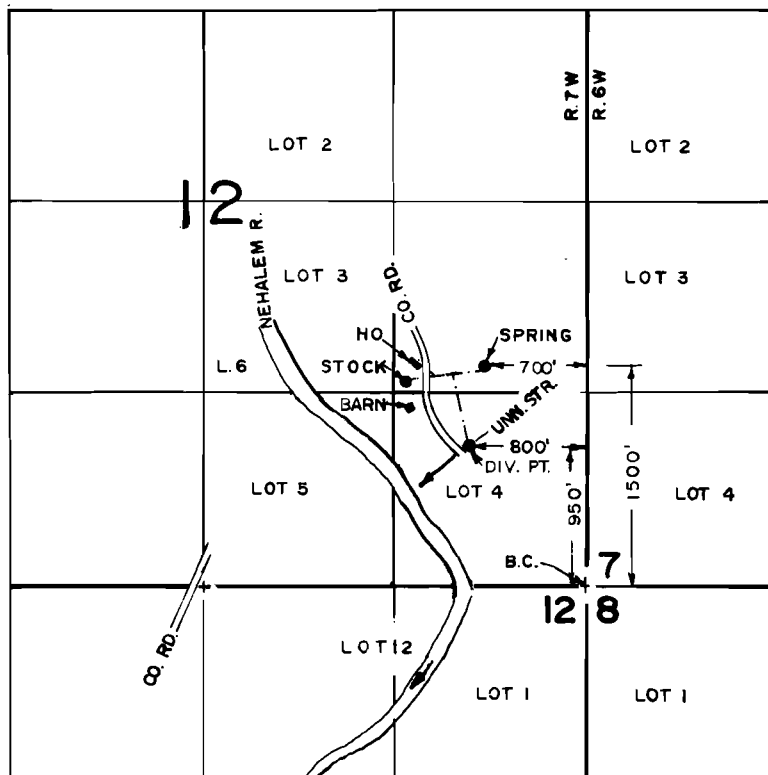

FINAL PROOF SURVEY
UNDER

Application No. 53953.. Permit No. 40246.....
IN NAME OF

.....SAMUEL H. LEE.....

Surveyed FEB. 21.. 1980, by R.G. MUCKEN.....