



P-40255
57480

T.13S., R.28E., W.M.

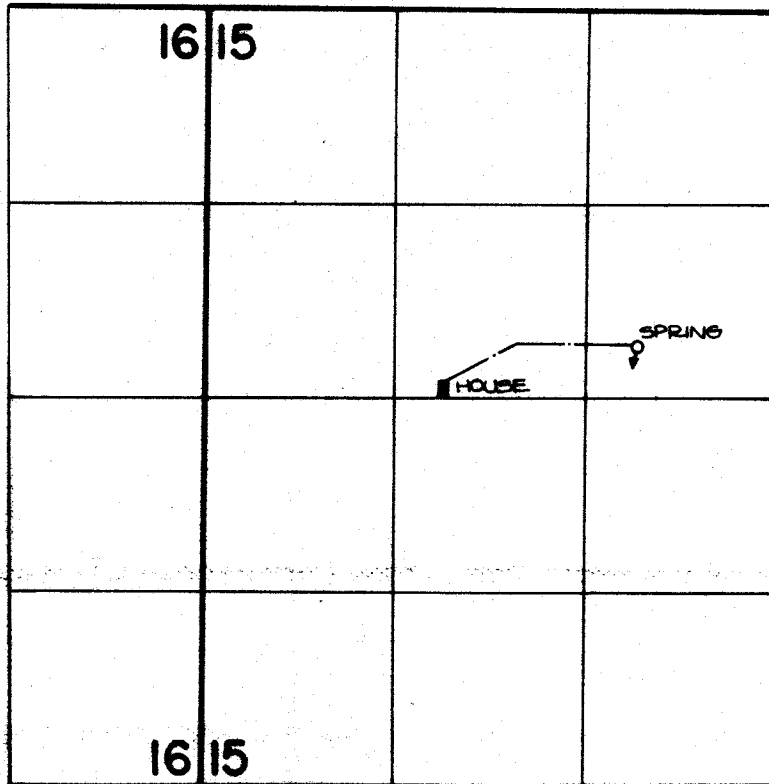

THE SPRING IS LOCATED 250 FT. N. AND 350 FT. E. FROM
THE CENTER OF SECTION 15.

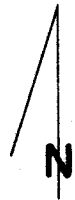

SCALE: 4" = 1 MILE

FINAL PROOF SURVEY
UNDER

Application No. 53977 Permit No. 40255
IN NAME OF

M.T. & ELIZABETH MERRILL

Surveyed AUG. 8, 1984, by P. Pagter