


T. 3&4 S., R. 5 W., W.M.

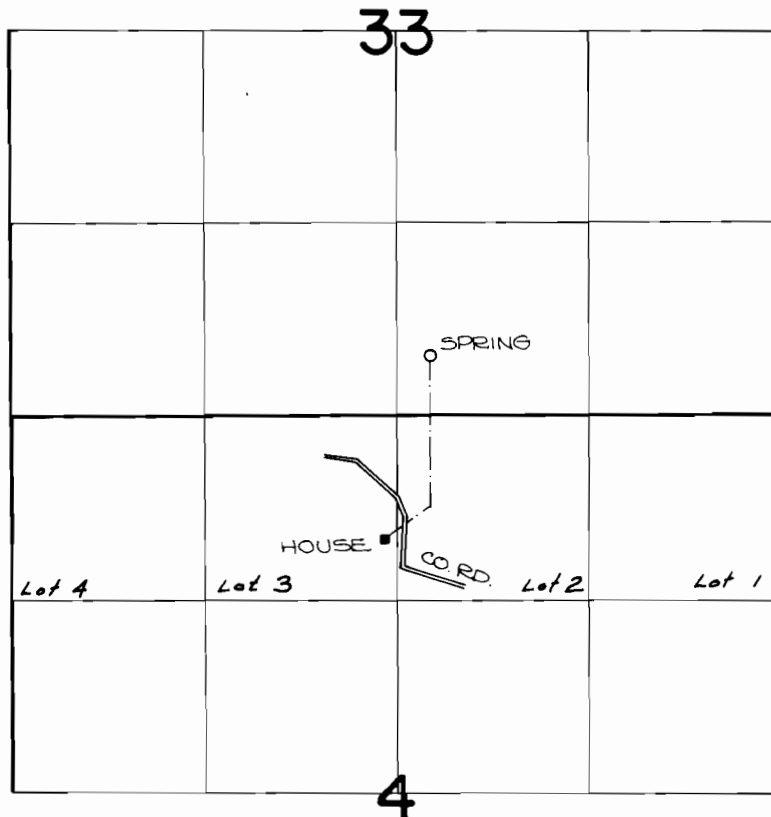

SPRING LOCATION: 410 FT. N. AND 230 FT. E. FROM
THE $\frac{1}{4}$ CORNER OF SECTION 33.

FINAL PROOF SURVEY
UNDER



SCALE: 4" = 1 MILE

Application No. 52963 Permit No. 40302
IN NAME OF

GEORGE A. & VALORIE L. KLAUSS

Surveyed JULY 25, 1984, by *P. Proctor*