


# T.37S., R.6 W., W.M

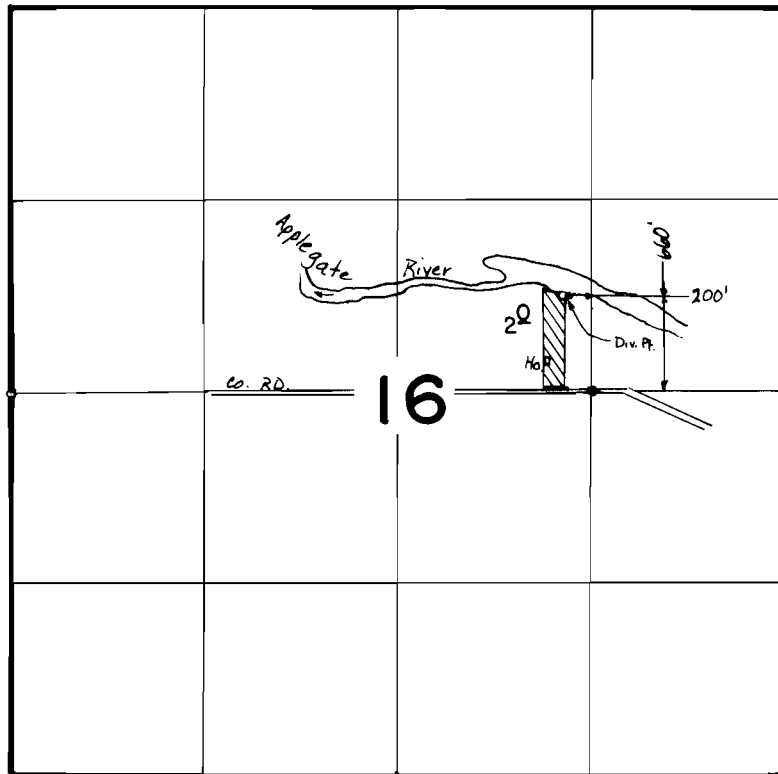

## FINAL PROOF SURVEY UNDER

Application No. 53722. Permit No. 40345....  
IN NAME OF

CORWIN & MYRTLE JOHNSON

Surveyed Q.C.T. 17. 1983., by B.S. JAMES.....