


T.37S., R.7W., W.M.

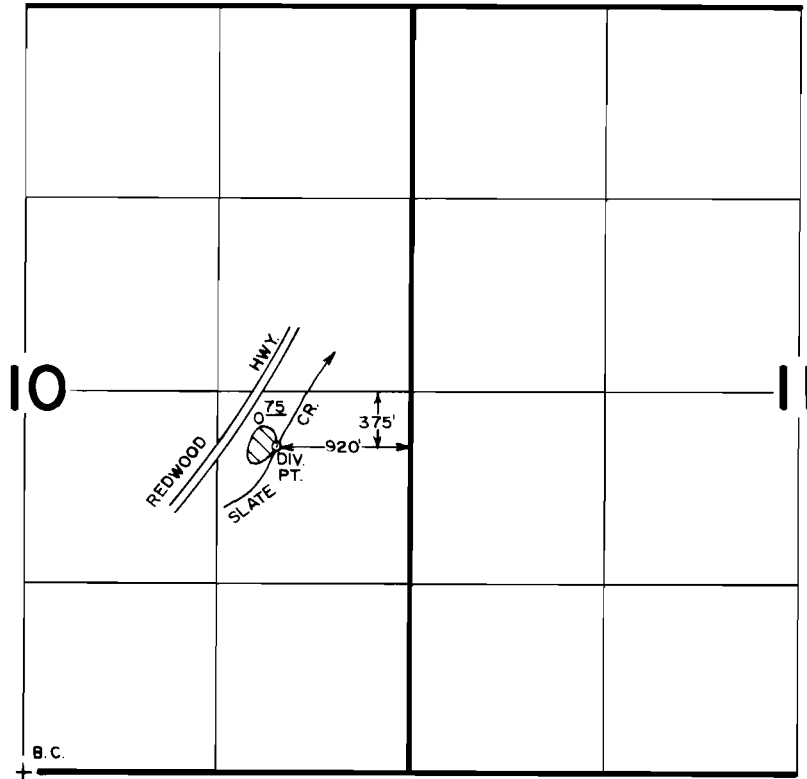

**FINAL PROOF SURVEY**  
UNDER

Application No. 53748 Permit No. 40363  
IN NAME OF

ANDY M. & VICTORIA L. PROCTOR

Surveyed OCT. 24 1983, by B. S. JAMES

SCALE : 4" = 1 MILE