


T.12S. R.8W. W.M.

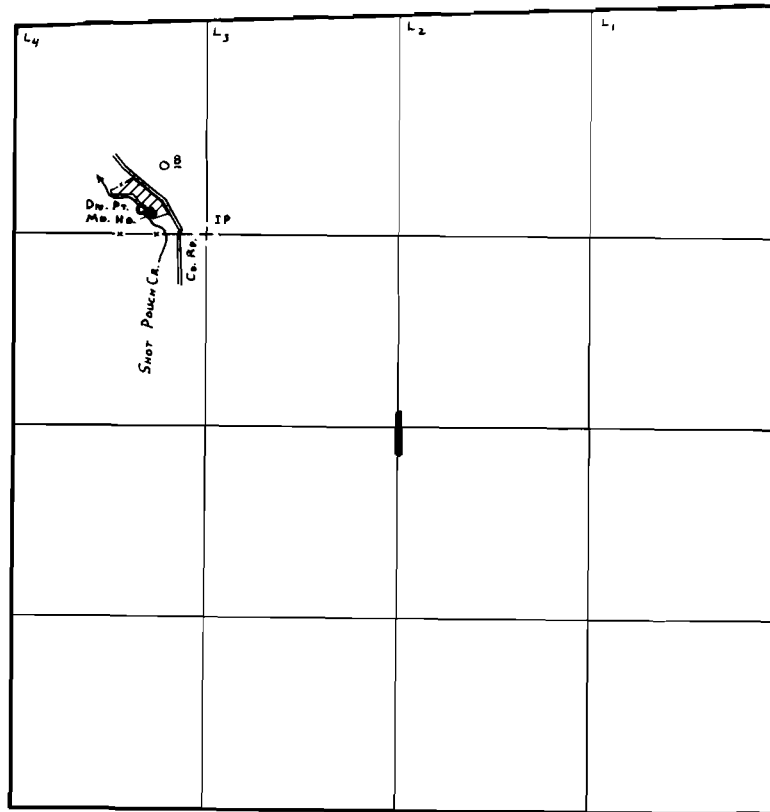

Div. Pt. Loc: 170' N. & 450' W. fr. S.E. Cor. Lot 4.

FINAL PROOF SURVEY
UNDER

Application No. 53801 Permit No. 40389.....
IN NAME OF

JOHN R. & JOY M. CHAMBERS.....

Surveyed May 23, 1980, by C. L. Hughes.....