


Contract No. 1  
 1700  
 1800  
 1900  
 2000  
 2100

See Map 2N 7 7B

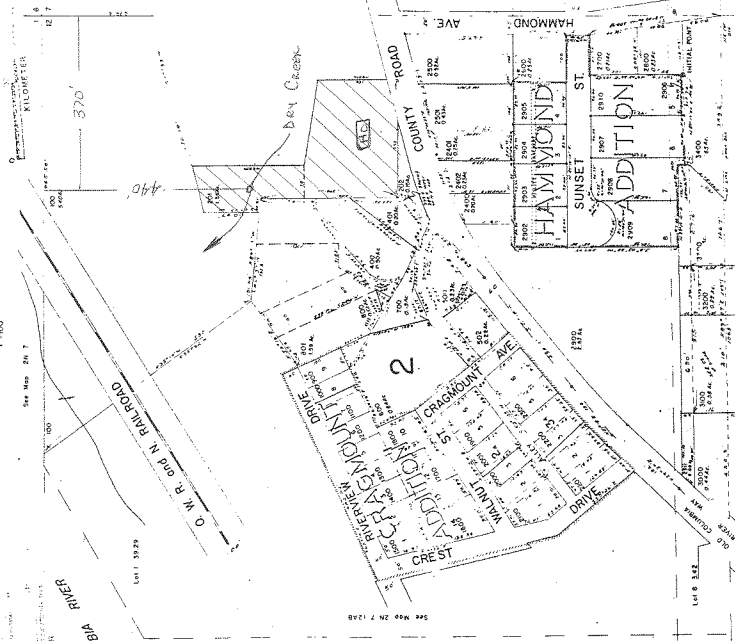

See Map 2N 7  
 1"=100'

370'  
 440'

COLUMBIA RIVER

See Map 2N 7 12AB

Map made from map in map books