


T. 2S., R. 44E., W. M.

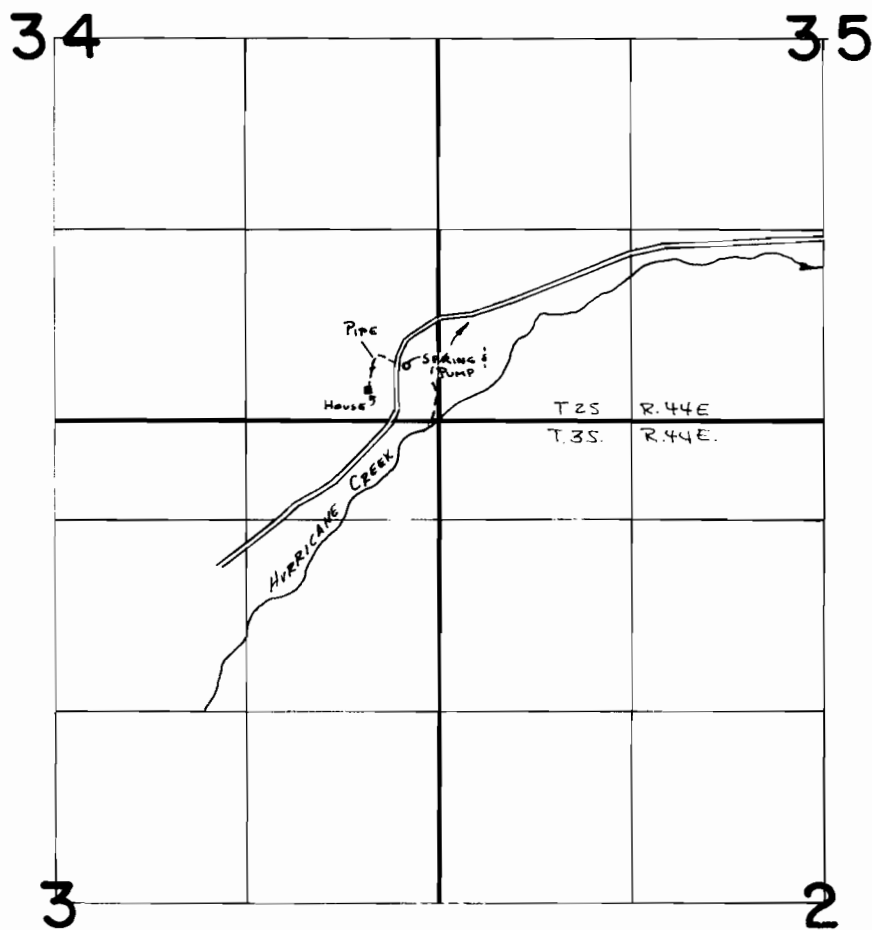

SPRING Loc: 480' N & 230' W. FROM SE COR. SEC. 34

FINAL PROOF SURVEY
UNDER

SCALE: 1" = 400'

Application No. **54029** Permit No. **40414**....
IN NAME OF

.....**GLENN H. ANDERSON**.....

Surveyed ..8-9..... 19.84, by ..V.L. Church.....