


# T.27S.,R.7W.,W.M.

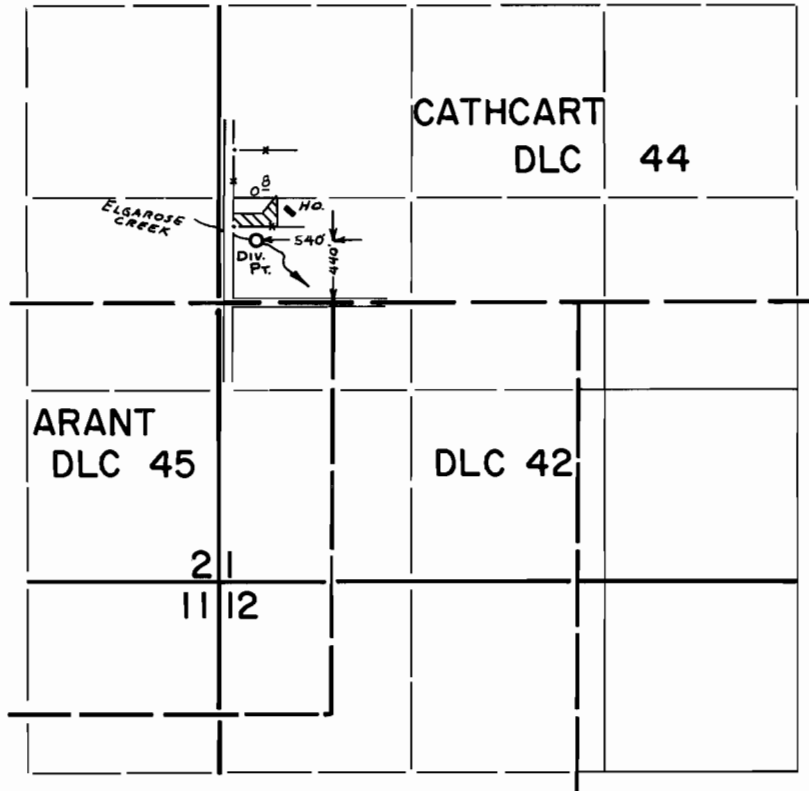

## FINAL PROOF SURVEY UNDER

Application No. .54051. Permit No. .40425....  
IN NAME OF

STEPHEN E. ADKINS

Surveyed June 24, 1982., by L.M. TOLL.....