


T. 28S., R. 5W., W.M.

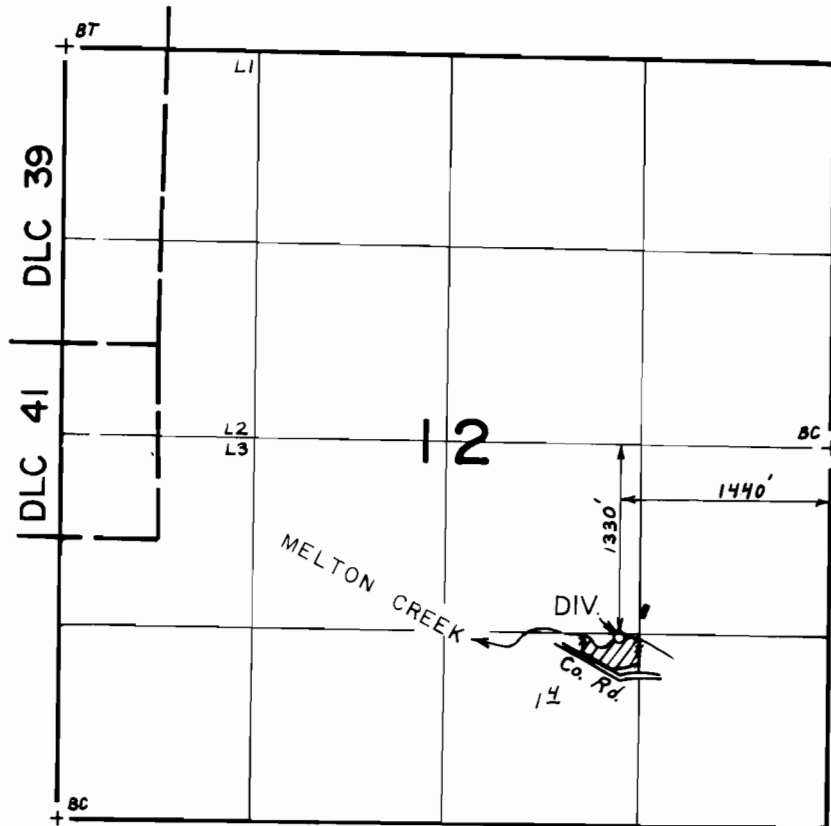

SCALE: 4" = 1 mile

FINAL PROOF SURVEY
UNDER

Application No. ~~53830~~ Permit No. ~~40454~~.....
IN NAME OF

BENJAMIN B. MELTON.....

Surveyed JULY...2, 1984., by *L. Cashion*.....