


30

29

28

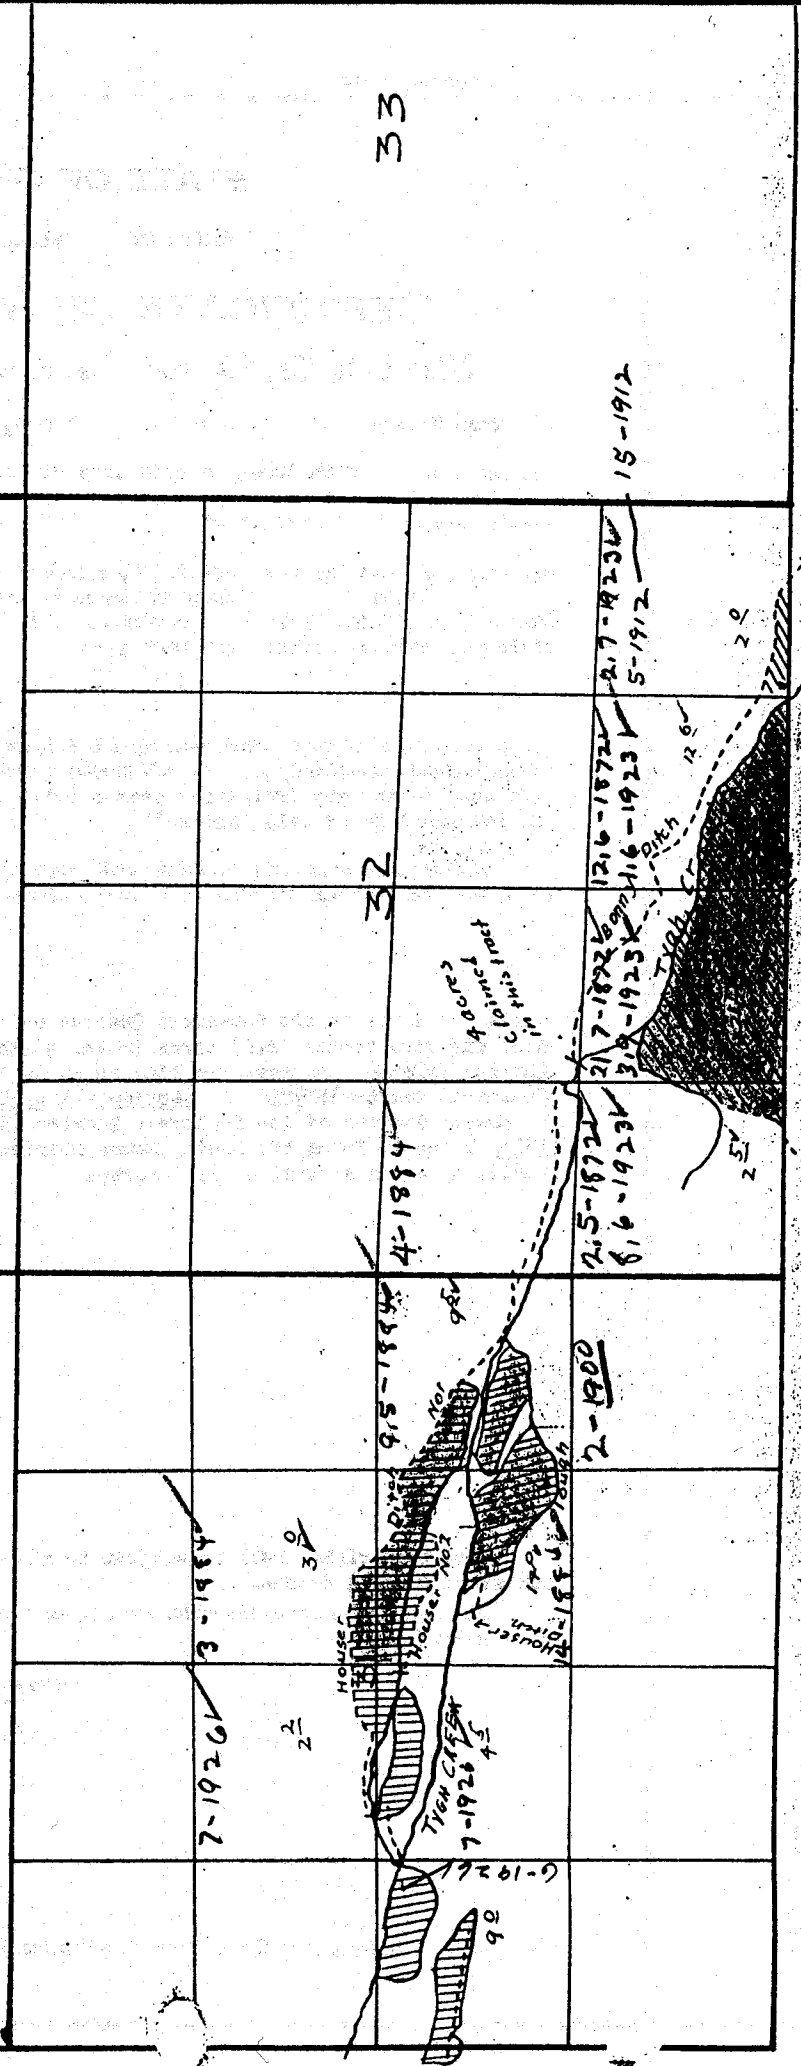

33