


T.1S. R.38E. W.M.

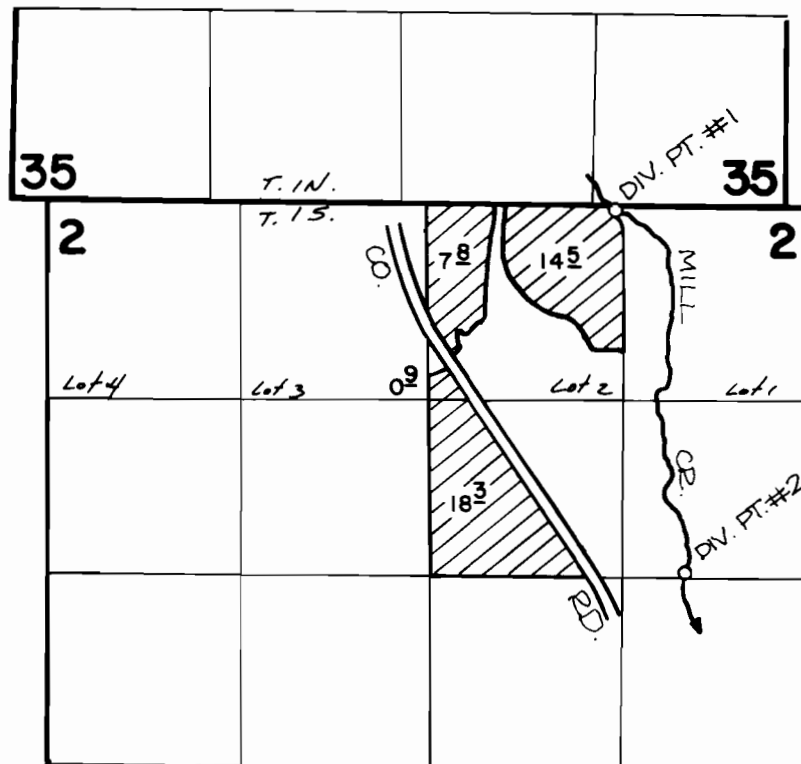

DIVERSION POINT #1 IS LOCATED 10'S. AND 1410'W. FROM THE N.E. CORNER OF SECTION 2. DIVERSION POINT #2 IS LOCATED 2510'S. AND 880'W. FROM THE N.E. CORNER OF SECTION 2.

FINAL PROOF SURVEY
UNDER

Application No. 54022. Permit No. 40475.....
IN NAME OF

.....ROBERT D. GOSS.....

Surveyed AUG. 24.. 19.83, by V....CHURCH.....