


P-40520
57492

T.13S., R.30E., W.M.

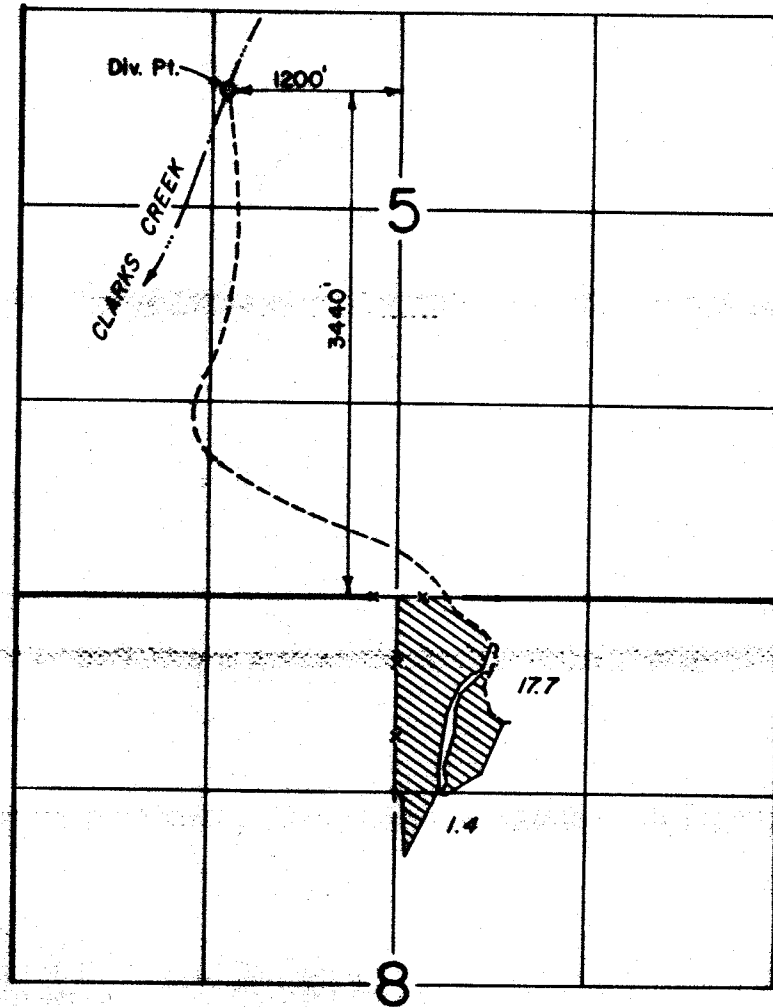

FINAL PROOF SURVEY
UNDER

Application No. 54129 Permit No. 40520
IN NAME OF

JAY MCKERN

Surveyed SEPT. 2, 1981 by AB