


T.37S., R.7 W., W.M.

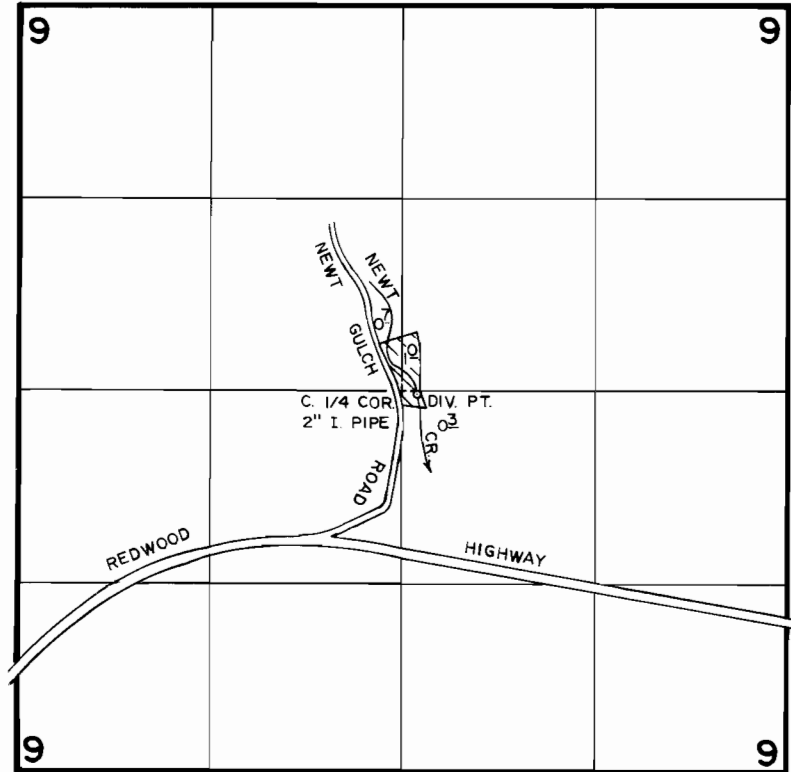

DIV. PT.: 20' S. & 100' E from CENTER SEC. 9

**FINAL PROOF SURVEY**  
UNDER

Application No. **54148** Permit No. **40538**  
IN NAME OF

**PAUL A. BENNETT**

Surveyed **OCT. 25** 19**83**, by **B. S. JAMES**

SCALE: 4" = 1 MILE