



T.6S.,R.6W.,W.M.

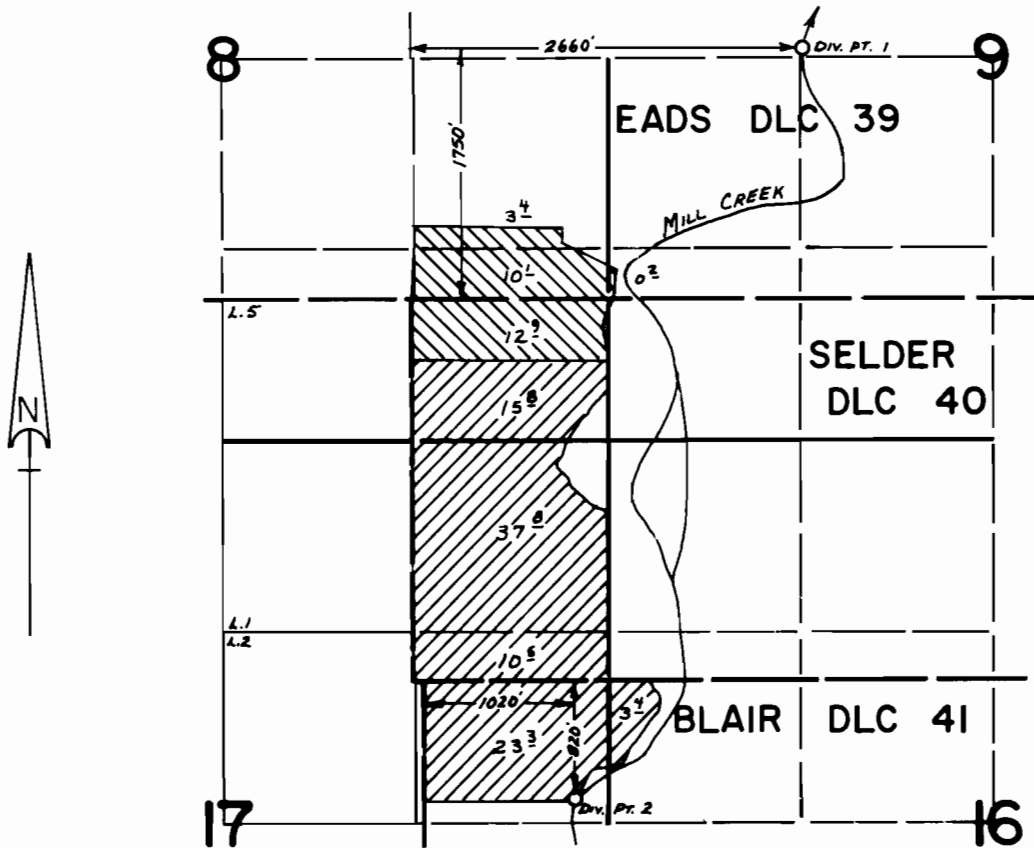

SCALE: 1" = 1320'

FINAL PROOF SURVEY UNDER

Application No. 54191 Permit No. 40612
 .56188... ..41564... 

IN NAME OF

.....RAYMOND L. RICE.....

Surveyed .Aug....4... 19.83., by .L.M..TOLL.....