


T.4N.R.4W.W.M.

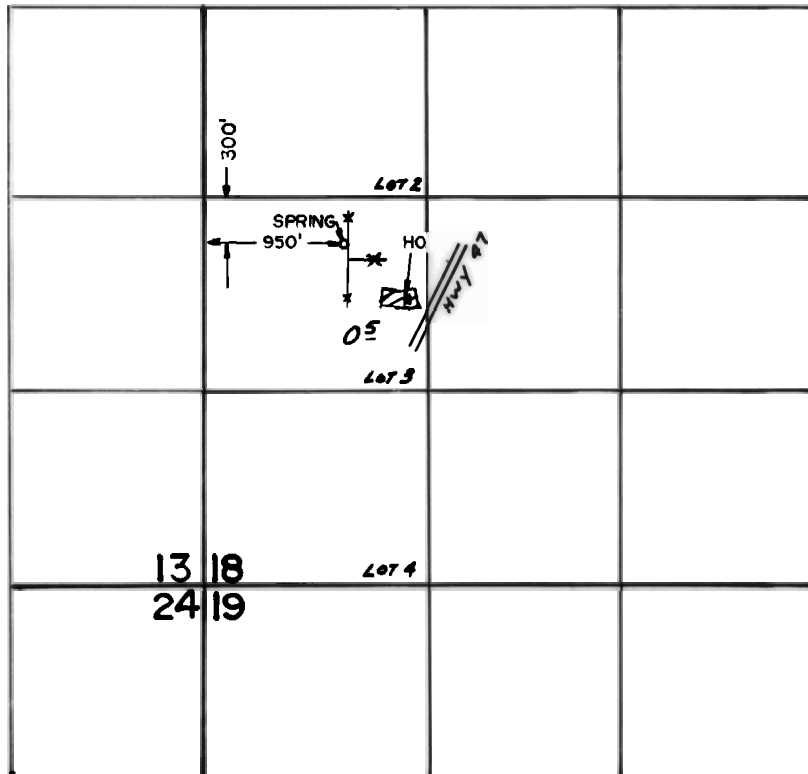

FINAL PROOF SURVEY
UNDER

Application No. 53943.. Permit No. 40705.....
IN NAME OF

.....RONALD I. & TAWNY K. SAMSA WOLFE.....

Surveyed MAY. 20. 1980., by R.G. MUCKEN.....