


T. 34 S., R. 6 W., W.M.

Sec. 36

SE 1/4 NE 1/4

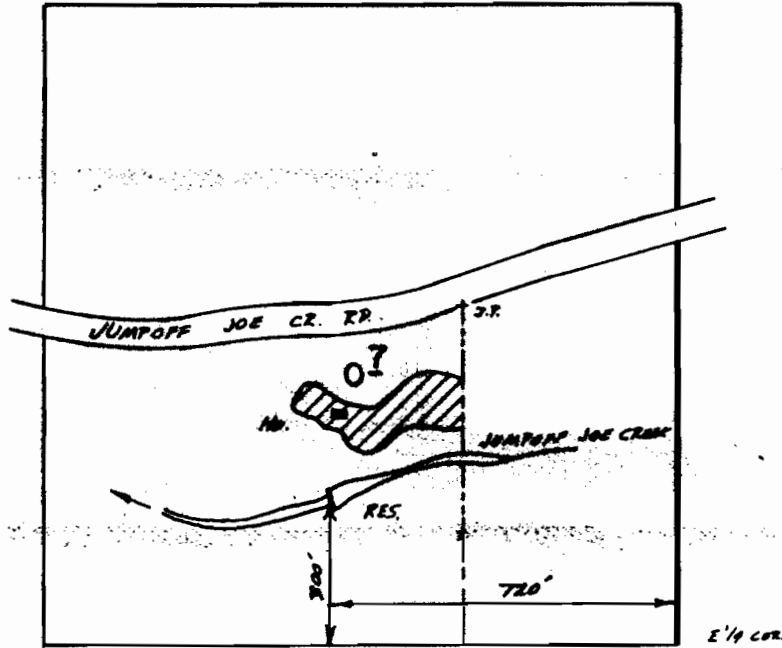

Scale 1" = 400'

FINAL PROOF SURVEY
UNDER

58878 44829
Application No. R-58877 Permit No. R-8126
IN NAME OF

.....MALCOLM.....DRAKE.....

Surveyed Sept. 19 1984, by J.R. WOODROOF