


T.26S.,R.7W.,W.M.

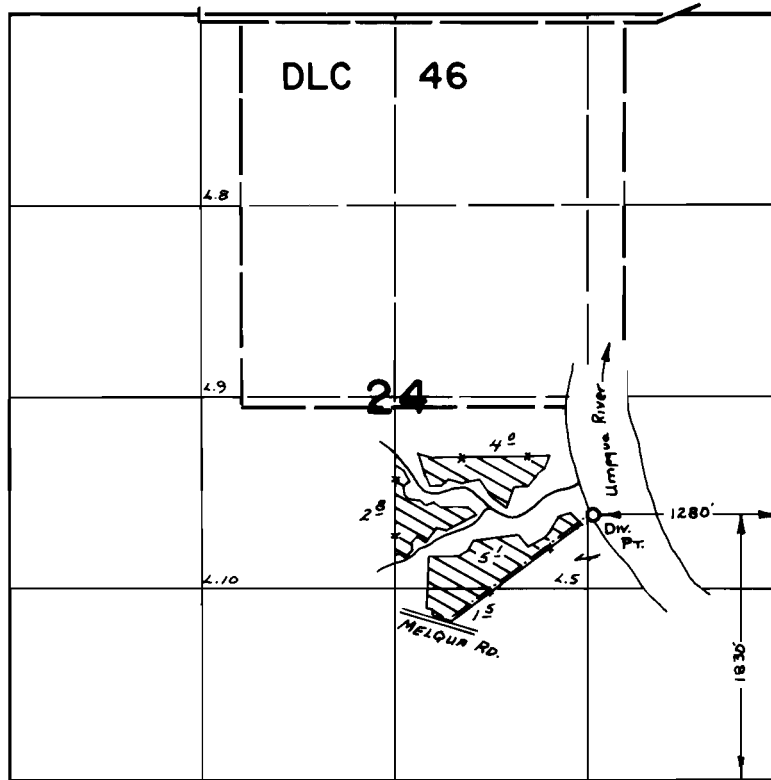

**FINAL PROOF SURVEY**  
UNDER

Application No. 54378.. Permit No. 40753.....  
IN NAME OF

.....**KIETH SPARLIN**.....

Surveyed May 12 1982, by L. M. TOLL.....