


T. 32 S. R. 5 W. W. M.

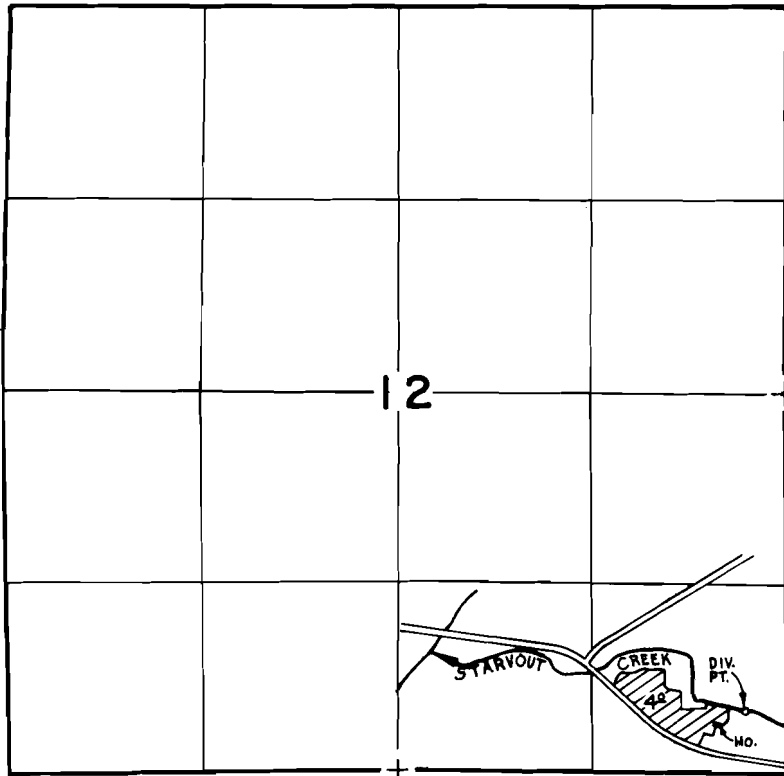

DIV. PT. LOCATED 2,180' S. & 280' W. FROM E. 1/4 CORNER SECTION 12

SCALE: 4" = 1 mile

FINAL PROOF SURVEY
UNDER

Application No. 54411... Permit No. 40773...
IN NAME OF

.....**HOMER JAMISON**.....

Surveyed NOV. 17, 1983., by ..L...GASHION..