


T. 34 S., R. 1 W., W.M  
SEC. 21

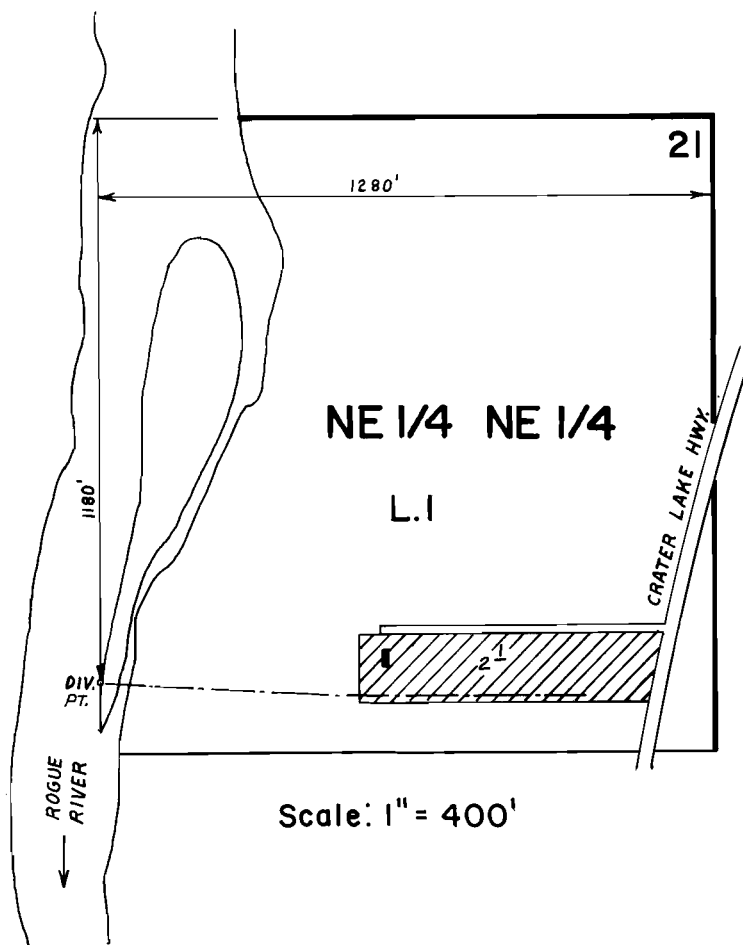

**FINAL PROOF SURVEY**  
UNDER

Application No. 54417 Permit No. 40805  
IN NAME OF

NEVIN H. JENSEN

Surveyed JUNE 24 1983, by B. S. JAMES