


T.1S.,R.5W.,W.M.

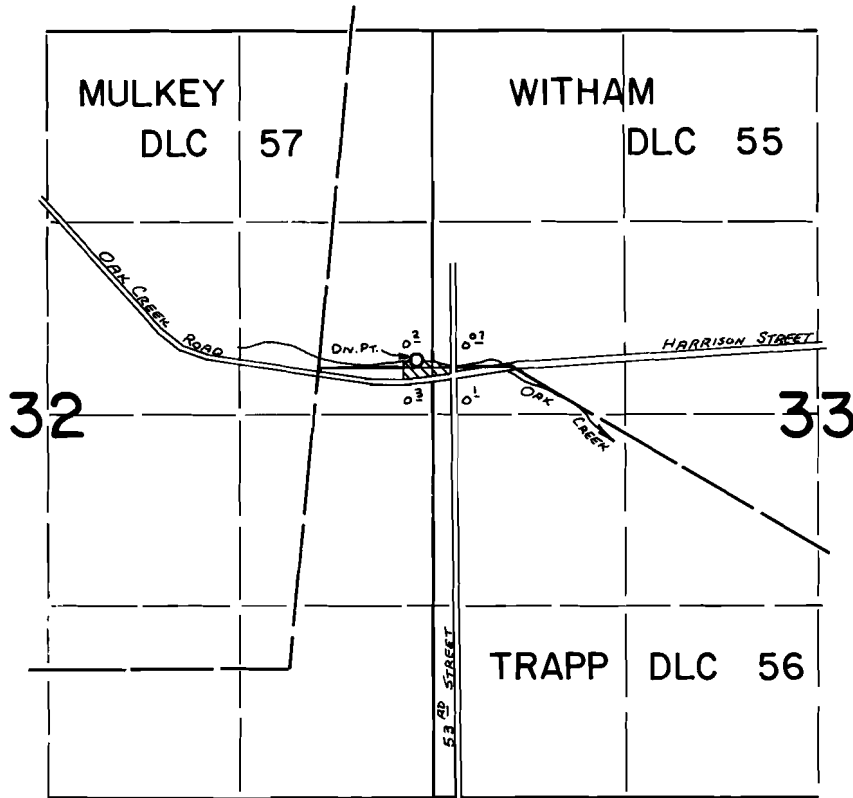

Div Pt- 50 ft N and 650 ft W from the NNE Cor Trapp DLC 56

FINAL PROOF SURVEY UNDER

Application No. 54458.. Permit No. 40853.....
IN NAME OF

HAROLD R. HEETER.....

Surveyed Aug. 30. 1982., by L.M. TOLL.....