


T.27S.,R.5W.,W.M.

Section 13

SE 1/4 of SW 1/4

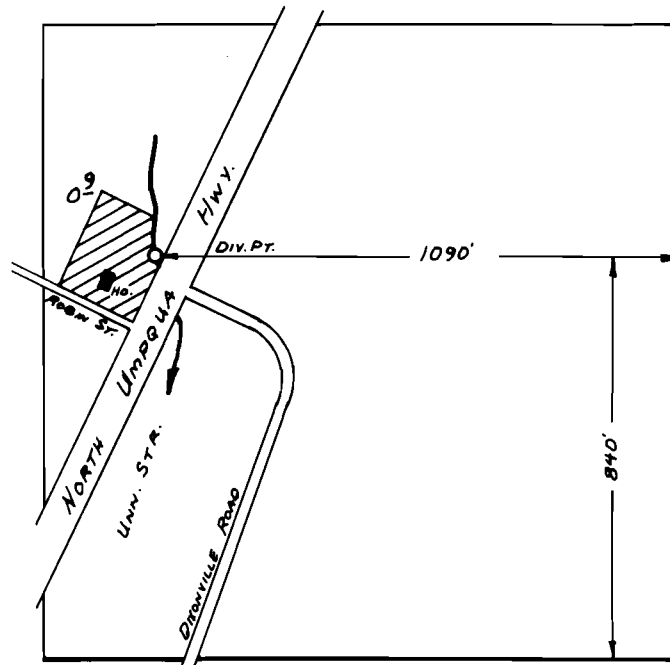

SCALE: 1" = 400'

FINAL PROOF SURVEY

UNDER

Application No. .54515... Permit No. .40927.....
IN NAME OF

.....**ROBERT M. HADWEN**.....

Surveyed Aug. 12... 1982., by .L.M. TOLL.....