


T.5S., R.1W., W.M.

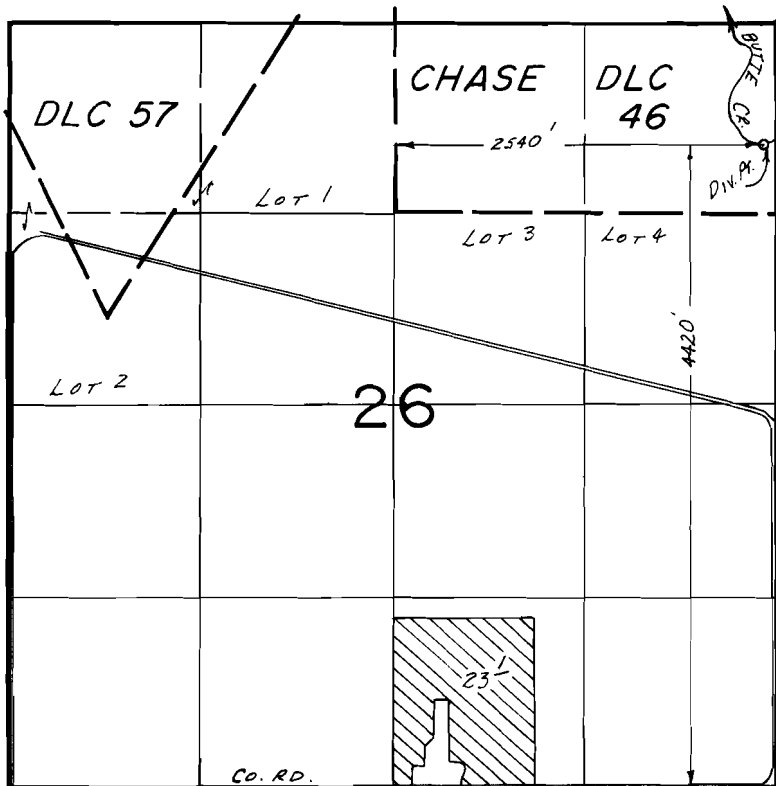

FINAL PROOF SURVEY
UNDER

Application No. 54572. Permit No. 40951.....
IN NAME OF

.....A. A. ANNEN.....

Surveyed OCT. 28. 1983. by L. M. TOLL.....